

MISSISSIPPI DEPARTMENT OF ENVIRONMENTAL QUALITY
Bureau of Land and Water Resources

P. O. Box 10631
Jackson, MS 39289-0631
WATER WELL DRILLERS LOG

COUNTY WELL LOCATED Simpson	
WELL NUMBER D 66	CODED
DATE WELL COMPLETED 11-21-90	

PERMIT NUMBER 0-402
NAME OF DRILLING FIRM Tom Griffith
Water Well

NAME & MAILING ADDRESS OF LANDOWNER Ensearch Exploration Attn: J. O. Smith 4849 GREENVILLE AVE. Suite 1200 Dallas TX 75206		
WELL LOCATION: SEC	TOWNSHIP	RANGE
20	2	4
DISTANCE	DIRECTION	NEAREST TOWN
4 Miles	W	of Mendenhall
OTHER LANDMARK 525' S + 2250' W of NE Cor		
WELL PURPOSE: Home, Irrigation, Municipal, Industrial, Fish Pond, etc. Reg Supply		

PUMP DATA		
PUMP TYPE (Circle One): <input checked="" type="radio"/> Submersible <input type="radio"/> Turbine, <input type="radio"/> Jet <input type="radio"/> Flowing Well, Other (Describe) _____		
POWER TYPE (Circle One): Electric, Tractor, Diesel, Gasoline, Butane, Other (Describe) S H/P _____		
Pump Capacity (GPM)	No. of Stages	Setting Depth
25 w/air lift		lift FT.
PUMP TEST		
Well yielded 70 GPM with a drawdown of _____ ft. after _____ hours of pumping		

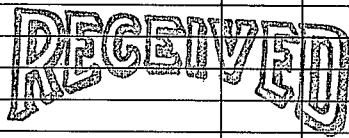
WELL DATA		
Well Depth 230'	Casing Diameter (In.) 4"	Casing Length (Ft.) 190'
Type of Casing PVC	Hole Depth 230'	Depth to Static Water Level 105'
TYPE OF COMPLETION: (Circle One or More): <input checked="" type="radio"/> Gravel Packed, <input type="radio"/> Underreamed, <input type="radio"/> Telescoped, <input checked="" type="radio"/> Natural Development, <input type="radio"/> Open Hole, <input type="radio"/> Other (Describe) _____		
Top of Lap Pipe or Reduction in Casing		
FEET	IF TELESCOPED OR MORE THAN ONE SCREEN: USE BACK PAGE	

LOG DATA	
TYPE OF LOG RUN (Circle One): Electric, Gamma Ray, Density, Sonic, <input checked="" type="radio"/> No Log Run, Neutron, Other (Describe) _____	
Name of Organization Running Log	

SCREEN DATA		
Diameter - Inches 4"	Length - Feet 40'	Slot Size - Inches .020
Screen Type PVC Slot	Depth to Bottom - Feet 230'	

GEOLOGIC DATA (Office Use Only)			
Surface Elev.	Geologic Unit	Unit Thickness	Depth to Top
Subs. SWL	Date	Analysis	Aquifer Test
Driller's Remarks			

DESCRIPTION OF FORMATIONS ENCOUNTERED	FROM	TO
Clay	0	15
Hard rock/limestone	15	38
Clay	38	40
Clay	40	60
Limestone/Hard Rock	60	140
Clay	140	180
Sand	180	230

FORMATIONS (Continued)	FROM	TO
 JAN 14 1991		
Dept. of Environmental Quality Bureau of Land & Water Resources		
IF MORE SPACE IS NEEDED, USE BACK		

If well telescopes please
sketch and show depths.

GROUND LEVEL

SECTION _____

Please indicate well location X.

ADDITIONAL INFORMATION

If more than one screen,
show location of each on sketch.