

Simpson
D 2000
11-14-75

MISSISSIPPI
 BOARD OF WATER COMMISSIONERS
 416 North State Street
 Jackson, Mississippi 39201

WATER WELL DRILLERS LOG

11-14 1975 Corner - Binn Simpson
 date well completed firm name county well located

LANDOWNER:
Mr. Cary Hilton
Mendenhall
 (mailing address)

WELL LOCATION:
 sec. 33 T 2 N R 4 E
S W
1 miles W of Zandford
 (distance) (direction) (nearest town)

WELL PURPOSE:
 (home, irrigation, municipal, industrial)

WELL COMPLETION DATA:

(1) diameter (inches) 4"

(2) total depth (feet) 200

(3) static water level (feet) 110 below top of ground.

(4) casing PVC 190
 (material) (depth)
4" if telescope see back.
 (size)

(5) screen 10 190
 (length) (depth to top)
4" (size) PVC (material)

(6) pump 3/4 12
 (HP) (yield gpm)

(type power)

(7) electric log NO
 (yes or no)

(organization running log)

(8) how well bottom plugged B.W. Value


description of formations encountered	from	to
<u>Top Soil</u>	<u>0</u>	<u>3</u>
<u>Clay</u>	<u>3</u>	<u>9</u>
<u>Sand & Gravel</u>	<u>9</u>	<u>34</u>
<u>Chalk</u>	<u>34</u>	<u>68</u>
<u>Sand & Gravel</u>	<u>68</u>	<u>79</u>
<u>Sand</u>	<u>79</u>	<u>200</u>

DRILLERS REMARKS:

RECEIVED
 NOV 20 1975
 MISS. RD. OF WATER COMMISSIONERS

If well telescopes please sketch and show depths.

GROUND LEVEL

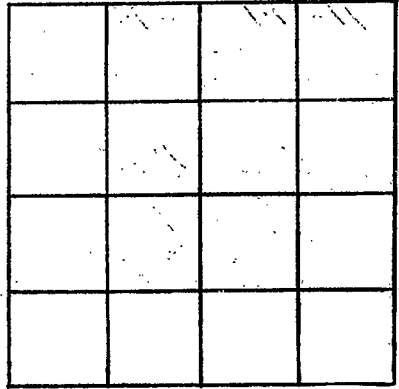

SECTION _____

Please indicate well location X.

ADDITIONAL INFORMATION

If more than one screen, show locations of each on sketch.