

MISSISSIPPI DEPARTMENT OF NATURAL RESOURCES

Bureau of Land and Water Resources

Southport Mall

P.O. Box 10631

Jackson, Mississippi 39209

WATER WELL DRILLERS LOG

*Simpson*  
D 2001

Oct 10 1983  
date well completed

83 Billy Elzy Drilling Co  
firm name

*Simpson*  
county well located

LANDOWNER: *Dale Thompson*  
*RT 1, BRAXTON, miss*  
*39044*  
(mailing address)

description of formations encountered	from	to
CLAY	0	95
ROCK	95	95.2
Sand	95.2	140

WELL LOCATION:

sec. 6 T. 2 (N) R. 4 (E)  
S W  
3 miles N of D'LO  
(distance) (direction) (nearest town)

WELL PURPOSE: *home*  
(home, irrigation, municipal, industrial)

WELL COMPLETION DATA:

- (1) diameter (inches) 5"
- (2) total depth (feet) 140'
- (3) static water level (feet) 105' below above top of ground.
- (4) casing P.V.C. 140'  
(material) (depth)  
2" If telescope see back.  
(size)
- (5) screen 5' 135'  
(length) (depth to top)  
1 1/2" Stamless Steel  
(size) (material)
- (6) pump \_\_\_\_\_ (HP) \_\_\_\_\_ (yield gpm)  
(type power)
- (7) electric log NO  
(yes or no)  
(organization running log)
- (8) how well bottom plugged \_\_\_\_\_

DRILLERS REMARKS:


DEPT. OF NATURAL RESOURCES  
BUREAU OF LAND & WATER RESOURCES

NOV - 7 1983

RECEIVED

If well telescopes please  
sketch and show depths.

GROUND LEVEL

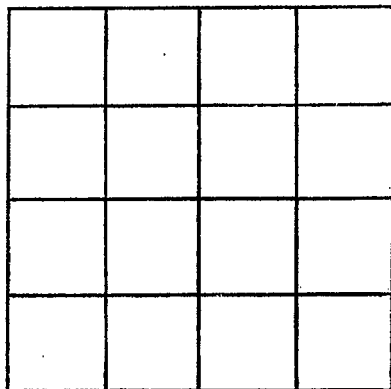

SECTION \_\_\_\_\_

Please indicate well location X.

ADDITIONAL INFORMATION

If more than one screen,  
show locations of each on sketch.