

MISSISSIPPI DEPARTMENT OF NATURAL RESOURCES

Bureau of Land and Water Resources

Southport Mall

P.O. Box 10631

Jackson, Mississippi 39209

WATER WELL DRILLERS LOG

Simpson
D 2002

5-13-88

Griner Drilling Service, Inc.

SIMPSON

date well completed

firm name

county well located

LANDOWNER:

description of formations encountered

from

to

Clayton W. Williams
Jr., Inc.

3000' clay, Desta Natl. Bank NO. 6 Desta Dr.

Midland, Texas 79705

WELL LOCATION: 2347N + 2425W

sec. 8 T. 2 N. R. 4 E of

Robinson miles (distance) of (direction) (nearest town)

WELL PURPOSE: oilfield no
(home, irrigation, municipal, industrial)

WELL COMPLETION DATA:

(1) diameter (inches) 4"

(2) total depth (feet) 357'

(3) static water level (feet) 130' below top of ground.

(4) casing steel, 294'
(material) (depth)

4"
(size) if telescope see back.

(5) screen 20', 274'
(length) (depth to top)

4", Stainless Steel
(size) (material)

(6) pump —, 75
(HP) (yield gpm)

AC
(type power)

(7) electric log —
(yes or no)


(organization running log)

(8) how well bottom plugged 6"

backwash valve

DRILLERS REMARKS:

description of formations encountered	from	to
<u>clay</u>	<u>0</u>	<u>150</u>
<u>streaked sand & clay</u>	<u>150</u>	<u>280</u>
<u>SAND</u>	<u>280</u>	<u>345</u>
<u>clay</u>	<u>345</u>	<u>357</u>

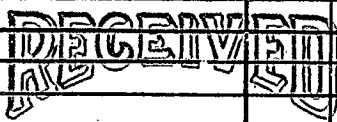


MAY 20 1988

Department of Natural Resources
Bureau of Land & Water Resources

If well telescopes please sketch and show depths.

GROUND LEVEL

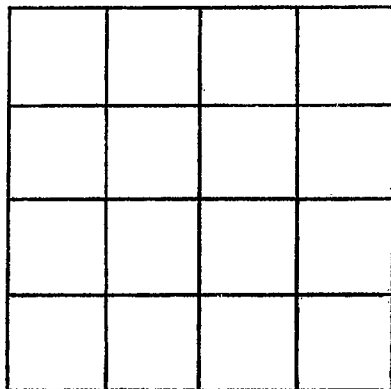

SECTION _____

Please indicate well location X.

ADDITIONAL INFORMATION

If more than one screen, show locations of each on sketch.