

SIMPSON
E 1
7-4-61

MISSISSIPPI BOARD OF WATER COMMISSIONERS

6

WATER WELL DRILLERS LOG

Date: July 4, 1961; Driller: W.G. Butler County Smith
(Name)

(1) Owner of Land: S.R. May
(Name)
Mendenhall, Miss.
(Address)

(2) Location: SE 1/4, SE 1/4, Sec. 7, T. 2 R. 5 E
10 miles North (distance), off Hwy. 13 (direction), of Mendenhall (Nearest Town)

(3) Topography: ✓
(Hilly) (Flat) (Level)

(4) Purpose of Well: Domestic
(Domestic Irrigation, Municipal, Industrial, Other)

Description & Color of Materials Sand, Clay, Red Clay, Shell, etc.	Thick- ness Feet	Depth Feet
Chalk	1	10
sand	10	15
Chalk	15	20
Rock	20	30
Chalk	30	40
sand	40	45
Chalk + Rock	45	50
Chalk	50	65
sand	65	82

Information upon completion of well:

(1) Diameter 2 inches.

(2) Total Depth 82 feet.

(3) Water Level 12 feet below top of ground.

(4) Cased to 77', Size 2"


(5) Screen: Size 2", Length 5'

(6) Were any formations sealed against pollution?
_____ yes, _____ no.

If YES depth of formation _____

Why _____

Drillers Remarks: _____

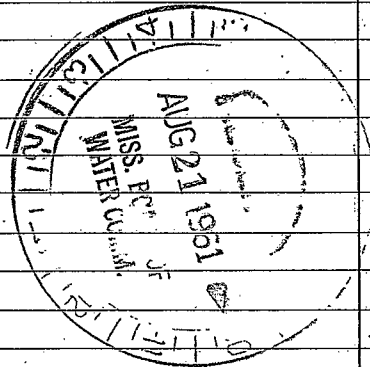

(Use Back Side)

Well No.

