

E.L. 74
act 864

Simpson
E.L.
4-67
E-109

MISSISSIPPI **CODED**
BOARD OF WATER COMMISSIONERS
416 North State Street
Jackson, Mississippi 39201

WATER WELL DRILLERS LOG

4-26 1967 Water Well Sur. Co. Simpson
date well completed firm name county well located

LANDOWNER: E.C. Ponder
Rt. Mendenhall, Miss.
(mailing address)

description of formations encountered	from	to
Blue clay	0	200
sand & clay	200	212
sand	212	241

WELL LOCATION: NE, NE, NW
sec. 5 T 2 N R 5 E
S W
5 miles N of Mendenhall
(distance) (direction) (nearest town)

WELL PURPOSE: Home
(home, irrigation, municipal, industrial)

WELL COMPLETION DATA:


- (1) diameter (inches) 2"
- (2) total depth (feet) 241
- (3) static water level (feet) 40 below top of ground above
- (4) casing 0 (material), (depth)
(size) If telescope see back.
- (5) screen 5' 235 (length) (depth to top)
2" 5.5 (size) (material)
- (6) pump 3/4 10 (HP) (yield gpm)
Elev. (type power)
- (7) electric log yes (yes or no)
Miss. Sur. Div. (organization running log)
- (8) how well bottom plugged

JUL - 6 1968
MISS. BOARD OF
WATER COMMISSIONERS

DRILLERS REMARKS:

If well telescopes please sketch and show depths.

GROUND LEVEL

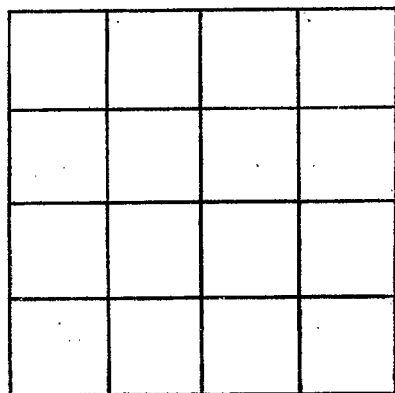

SECTION _____

Please indicate well location X.

ADDITIONAL INFORMATION

If more than one screen, show locations of each on sketch.