

Simpson

E5

7-66

MISSISSIPPI BOARD OF WATER COMMISSIONERS

CODED

WATER WELL DRILLERS LOG

Date: July 8, 1966, Driller: W. G. Butler County Simpson

(1) Owner of Land: R. T. Valentine
(2) Location: Mendonhall, Rt. 1 Miss
1/4 Sec. 25 T2R5


Table with 3 columns: Description & Color of Materials, Thickness Feet, Depth Feet. Rows include Red Chalk, Chalk, Rock, Rock + shale, Sand.

(3) Topography: (Hilly) (Flat) (Level)
(4) Purpose of Well: Domestic

Information upon completion of well:

(1) Diameter 2 inches.
(2) Total Depth 80 feet.
(3) Water Level 70 feet below top of ground.
(4) Cased to 80', Size 2"
(5) Screen: Size 2", Length 5'
(6) Were any formations sealed against pollution? No.

If YES depth of formation
Why
Drillers Remarks:
Yield in gpm: 3
Size pump: 1 HP
Type power: Electric

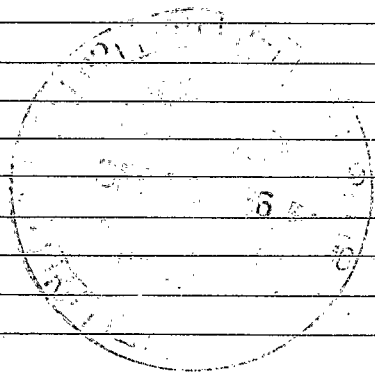

Retain this copy for your office files.

