

SIMPSON  
E 6  
10-67

MISSISSIPPI  
BOARD OF WATER COMMISSIONERS  
416 North State Street  
Jackson, Mississippi 39201

CODED

WATER WELL DRILLERS LOG

Oct. 5 - 1967 W. H. Dallas Well Repair Sengason  
date well completed firm name county well located

LANDOWNER:  
Mauren Hankins  
Martinsville  
(mailing address)

description of formations encountered	from	to
Clay	0	2.5
Chalk & Sand	2.5	4.5
Water Sand	4.5	7.5

WELL LOCATION:  
sec. 13 T. 2 N. R. 5 E  
S W  
miles N of Martinsville  
(distance) (direction) (nearest town)

WELL PURPOSE:  
(home, irrigation, municipal, industrial)

- WELL COMPLETION DATA:
- (1) diameter (inches) 2 in
  - (2) total depth (feet) 7.5
  - (3) static water level (feet) 43 below top of ground.
  - (4) casing ~~None~~ No de  
(material) (depth)
  - (size) if telescope see back.
  - (5) screen 16 ft 32  
(length) (depth to top)
  - 1/4" bogal. Brass  
(size) (material)
  - (6) pump (HP) (yield gpm)
  - (type power)
  - (7) electric log No  
(yes or no)
  - (organization running log)
  - (8) how well bottom plugged


CODED

50000-4-1963  
MISS. BOARD OF  
WATER COMM.

DRILLERS REMARKS:

If well telescopes please sketch and show depths.

GROUND LEVEL

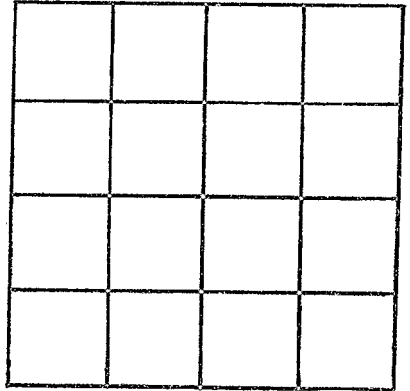

SECTION \_\_\_\_\_

Please indicate well location X.

ADDITIONAL INFORMATION

If more than one screen,  
show locations of each on sketch.