

Simpson
E #1
10-67

MISSISSIPPI
BOARD OF WATER COMMISSIONERS
416 North State Street
Jackson, Mississippi 39201

CODED

WATER WELL DRILLERS LOG

date well completed Oct 14 1967 firm name W. H. Butler Water Well Svc. Simpson county well located Simpson

LANDOWNER: Max L. D. Thomas
Mendenhall Miss.
RT
(mailing address)

WELL LOCATION:
sec. 36 T 2 N R. 5 E
S W
1 miles E of Martinville
(distance) (direction) (nearest town)

WELL PURPOSE: home
(home, irrigation, municipal, industrial)


- WELL COMPLETION DATA:
- (1) diameter (inches) 2"
 - (2) total depth (feet) 120'
 - (3) static water level (feet) 55 ^{below} top of ground.
 - (4) casing galv., 15'
(material) (depth)
2" If telescope see back.
(size)
 - (5) screen 5', 115'
(length) (depth to top)
2", st. steel
(size) (material)
 - (6) pump 1/2 10
(HP) (yield gpm)
Electric
(type power)
 - (7) electric log No
(yes or no)
 - (organization running log)
 - (8) how well bottom plugged 2" B.W.V.

description of formations encountered	from	to
Red sand & Red clay	1	10
Sand	10	15
Rock & Chalk	15	30
Chalk	30	40
Rock & Chalk	40	60
Chalk	60	70
Rock & Chalk	70	75
Sand & Chalk	75	80
Fine Sand	80	90
Sand & Chalk	90	100
Sand	100	120

DRILLERS REMARKS:

If well telescopes please sketch and show depths.

GROUND LEVEL

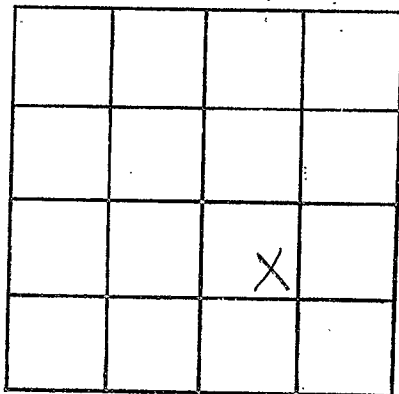

SECTION 36

Please indicate well location X.

ADDITIONAL INFORMATION

If more than one screen, show locations of each on sketch.