

SIMPSON MISSISSIPPI BOARD OF WATER COMMISSIONERS

E 9  
4-25-62

WATER WELL DRILLERS LOG

CODED

Date: April, 1925, Driller: W. G. Bullen County Smith  
(Name)


(1) Owner of Land:	Description & Color of Materials Sand, Clay, Red Clay, Shell, etc.	Thick- ness Feet	Depth Feet
<u>Frank May</u> (Name)	<u>CLAY</u>	<u>1-</u>	<u>5</u>
<u>Mendenhall, Miss</u> (Address)	<u>SAND + GRAVEL</u>	<u>5-</u>	<u>10</u>
(2) Location: <u>1/4</u> , <u>1/4</u> , Sec. <u>5</u> <u>T1N R5E</u>	<u>ROCK</u>	<u>10-</u>	<u>15</u>
<u>4</u> miles <u>South</u> of <u>Packet</u> (distance) (direction) (Nearest Town)	<u>CHALK</u>	<u>15-</u>	<u>20</u>
(3) Topography: <input checked="" type="checkbox"/> (Hilly) <input type="checkbox"/> (Flat) <input type="checkbox"/> (Level)	<u>ROCK + BLUE GUMBO</u>	<u>20-</u>	<u>50</u>
(4) Purpose of Well: <u>Domestic</u> (Domestic Irrigation Municipal, Industrial, Other)	<u>CHALK</u>	<u>50-</u>	<u>60</u>
	<u>FINE SAND + CHALK</u>	<u>60-</u>	<u>90</u>
	<u>CHALK</u>	<u>90-</u>	<u>95</u>
	<u>SAND</u>	<u>95-</u>	<u>110</u>

Information upon completion of well:

- (1) Diameter 2 inches.
- (2) Total Depth 110 feet.
- (3) Water Level 50 feet below top of ground.
- (4) Cased to 115, Size 2"
- (5) Screen: Size 2", Length 5
- (6) Were any formations sealed against pollution?  
\_\_\_\_\_ yes, \_\_\_\_\_ no.

If YES depth of formation \_\_\_\_\_  
Why \_\_\_\_\_

Drillers Remarks: \_\_\_\_\_  
\_\_\_\_\_  
\_\_\_\_\_

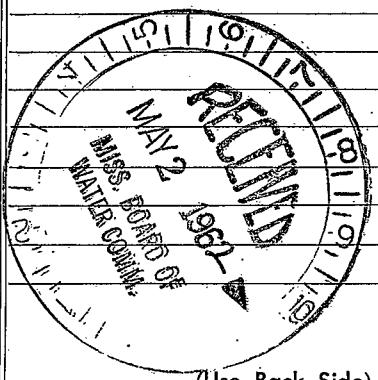

Well No.

