

E 11

11-21-63

WATER WELL DRILLERS LOG

CODED 7

Date: Nov. 21, 1963, Driller: W. G. Butcher County Smith
 (Name)

(1) Owner of Land: Fred Milner
 (Name)
Wanda Marshall, Miss.
 (Address)

(2) Location: 1/4, 1/4, Sec. 1 T21R5E
6 miles South.W. of Packett
 (distance) (direction) (Nearest Town)

(3) Topography:
 (Hilly) (Flat) (Level)

(4) Purpose of Well: Domestic
 (Domestic Irrigation
 Municipal, Industrial, Other)

Description & Color of Materials Sand, Clay, Red Clay, Shell, etc.	Thick- ness Feet	Depth Feet
Red clay	1-8	
sand	8-20	
chalk	20-30	
Rock + chalk	30-40	
chalk	40-70	
Rock + chalk	70-100	
chalk	100-105	
sand	105-110	
chalk	110-118	

Information upon completion of well:

(1) Diameter 2 inches.

(2) Total Depth 118 feet.

(3) Water Level 80 feet below top of ground.

(4) Cased to 105, Size 3"


(5) Screen: Size 2", Length 10

(6) Were any formations sealed against pollution?
 yes, no.

If YES depth of formation

Why

Drillers Remarks:

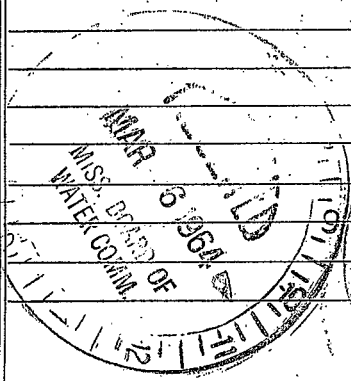

(Use Back Side)

Well No.

