

SIMPSON MISSISSIPPI BOARD OF WATER COMMISSIONERS

E 13

8-22-64

WATER WELL DRILLERS LOG

CODED

Simpson
Smith

Date: Aug. 22, 1964, Driller: W. G. Butler County Smith
(Name)

(1) Owner of Land: Doc Cook
(Name)
Mendenhall Rt 1
(Address) Miss

(2) Location: 1/4, 1/4, Sec. 1 T² R⁵ E⁴
_____ miles _____ of _____
(distance) (direction) (Nearest Town)

(3) Topography: _____
(Hilly) (Flat) (Level)

(4) Purpose of Well: Domestic
(Domestic Irrigation
Municipal, Industrial, Other)

Description & Color of Materials Sand, Clay, Red Clay, Shell, etc.	Thick- ness Feet	Depth Feet
<u>Clay</u>	<u>1-</u>	<u>10</u>
<u>Sand</u>	<u>10-</u>	<u>20</u>
<u>Blue Chalk</u>	<u>20-</u>	<u>40</u>
<u>Fine Sand</u>	<u>40-</u>	<u>45</u>
<u>Chalk</u>	<u>45-</u>	<u>60</u>
<u>Chalk & Sand</u>	<u>60-</u>	<u>65</u>
<u>Sand</u>	<u>65-</u>	<u>78</u>

Information upon completion of well:

(1) Diameter 2 inches.

(2) Total Depth 78 feet.

(3) Water Level _____ feet below top of ground.


(4) Cased to 75, Size 2"

(5) Screen: Size 2", Length 5'

(6) Were any formations sealed against pollution?
_____ yes, _____ no.

If YES depth of formation _____
Why _____

Drillers Remarks: _____

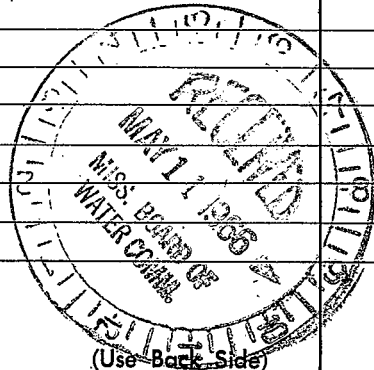

Well No. _____

(Use Back Side)

1942
[Faint, illegible text]

[Extremely faint and illegible text, possibly bleed-through from the reverse side of the page]

1942
[Faint, illegible text]