

6 ~~REI4~~
8-8-60

WATER WELL DRILLERS LOG

CODED

Date: Aug 8, 1960, Driller: JAMES A. WATSON (Name) Madison County

(1) Owner of Land: Fordie Sullivan
(Name)
Magee
(Address)

(2) Location: 1/4, 1/4, Sec. 23 T. 2 R. 5,
7 miles north of Magee,
(distance) (direction) (Nearest Town)

(3) Topography: X
(Hilly) (Flat) (Level)

(4) Purpose of Well: Domestic
(Domestic Irrigation
Municipal, Industrial, Other)

Description & Color of Materials Sand, Clay, Red Clay, Shell, etc.	Thick- ness Feet	Depth Feet
<u>Red Sand</u>	<u>20</u>	
<u>80 ft sand</u>	<u>80</u>	<u>100</u>

CODED

Information upon completion of well:

(1) Diameter 2 inches.


(2) Total Depth 100 feet.

(3) Water Level 95 feet below top of ground.

(4) Cased to 95, Size _____.

(5) Screen: Size 1/4" Length 5 ft
1/4" Stanley Steel Band
Showing 3 ft.

(6) Were any formations sealed against pollution?
_____ yes, X no.

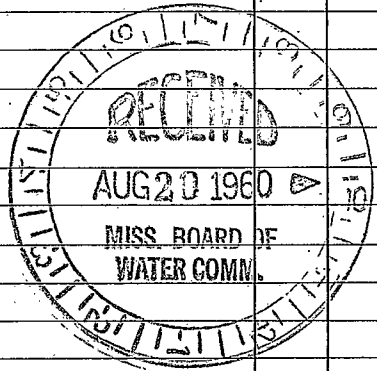

If YES depth of formation _____

Why _____

Drillers Remarks: _____

Well No.

(Use Back Side)

