

13T

CODED

CODED

CODED

SIMPSON
E 17
9-68

MISSISSIPPI  
BOARD OF WATER COMMISSIONERS  
416 North State Street  
Jackson, Mississippi 39201

WATER WELL DRILLERS LOG

Sept 1968 J.P. Simpson Simpson  
date well completed firm name county well located

LANDOWNER:	description of formations encountered	from	to
<u>M.S. Mason</u>	<u>clay</u>	<u>0</u>	<u>9</u>
(mailing address)	<u>sand gravel</u>	<u>9</u>	<u>30</u>
WELL LOCATION: sec. <u>19</u> T <u>2</u> N R. <u>5</u> E	<u>Rock</u>	<u>30</u>	<u>40</u>
<u>2</u> miles <u>W-E</u> of <u>mandeville</u>	<u>blue clay</u>	<u>40</u>	<u>48</u>
(distance) (direction) (nearest town)	<u>synclinal</u>	<u>48</u>	<u>53</u>
WELL PURPOSE: <u>home</u> (home, irrigation, municipal, industrial)	<u>sand gravel</u>	<u>53</u>	<u>65</u>
WELL COMPLETION DATA:	<u>sand</u>	<u>65</u>	<u>78</u>
(1) diameter (inches) <u>2"</u>			
(2) total depth (feet) <u>78</u>			
(3) static water level (feet) <u>55'</u> below above top of ground.			
(4) casing <u>gal.</u> <u>73</u> (material) (depth)			
<u>2"</u> (size) If telescope see back.			
(5) screen <u>5'</u> <u>78'</u> (length) (depth to top)			
<u>1/4"</u> <u>brass</u> (size) (material)			
(6) pump <u>3/4</u> <u>6</u> (HP) (yield gpm)			
<u>jet</u> (type power)			
(7) electric log <u>no</u> (yes or no)			
(organization running log)			
(8) how well bottom plugged <u>B/2/2/2/2/2</u>			
DRILLERS REMARKS:			

CODED


CODED

NOV 25 1968

MISS. Bd. OF WATER COMM.

If well telescopes please sketch and show depths.

GROUND LEVEL

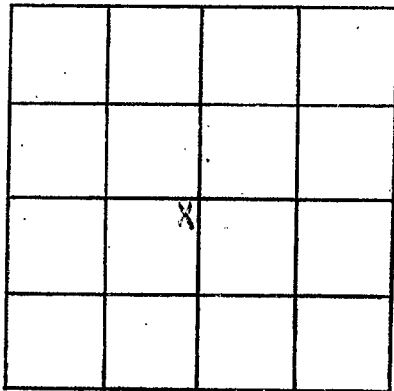

SECTION 19

Please indicate well location X.

ADDITIONAL INFORMATION

120 50  
47 20

*Handwritten notes and signatures*

*Handwritten notes on lined paper:*  
18  
55  
8"  
2'  
12'  
14'  
16'  
18'  
20'  
22'  
24'  
26'  
28'  
30'  
32'  
34'  
36'  
38'  
40'

If more than one screen, show locations of each on sketch.