

Simpson
E 18
11-30-68

MISSISSIPPI
 BOARD OF WATER COMMISSIONERS
 416 North State Street
 Jackson, Mississippi 39201

CODED

WATER WELL DRILLERS LOG

Nov. 30 1969 H. E. Thompson Simpson
 date well completed firm name county well located

LANDOWNER: E. L. Lupton
Martinwill Mrs.
 (mailing address)

description of formations encountered

clay CODED
Sand

from to
0 10
10 108

WELL LOCATION:
 sec 36 T 2 N R 5 E
1 miles S-E of Martinwill
 (distance) (direction) (nearest town)

WELL PURPOSE: Dairy
 (home, irrigation, municipal, industrial)

- WELL COMPLETION DATA:
- (1) diameter (inches) 2"
 - (2) total depth (feet) 108'
 - (3) static water level (feet) 21' below above top of ground.
 - (4) casing Gal, 98'
 (material) (depth)
2"
 (size) if telescope see back.
 - (5) screen 10', 98'
 (length) (depth to top)
1 1/4, S.S. Johnson
 (size) (material)
 - (6) pump 1 20
 (HP) (yield gpm)
Jet
 (type power)
 - (7) electric log no.
 (yes or no)
 (organization running log)
 - (8) how well bottom plugged B/K Johnson


CODED
 CODED

FEB 12 1969
 MISS. Bd. of
 WATER COM. L.

DRILLERS REMARKS:

If well telescopes please sketch and show depths.

GROUND LEVEL

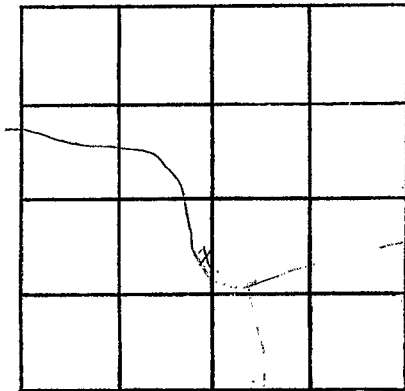

SECTION 36

Please indicate well location X.

ADDITIONAL INFORMATION

If more than one screen, show locations of each on sketch.