

Simpson
E 19.
12-4-68

MISSISSIPPI
 BOARD OF WATER COMMISSIONERS
 416 North State Street
 Jackson, Mississippi 39201

CODED

WATER WELL DRILLERS LOG

Dec. 4, 1968 19 R. E. Thompson Simpson
 date well completed firm name county well located

LANDOWNER: A. Davis
Marshall Miss.
 (mailing address)

description of formations encountered	from	to
<u>clay</u>	<u>0</u>	<u>10</u>
<u>Red sand.</u>	<u>10</u>	<u>50</u>
<u>Red sand</u>	<u>50</u>	<u>75</u>
<u>sand.</u>	<u>75</u>	<u>105</u>

WELL LOCATION:
 sec. 35 T 2 N R 8 E
1/4 miles S-E of Marshall
 (distance) (direction) (nearest town)

WELL PURPOSE: Drain
 (home, irrigation, municipal, industrial)

WELL COMPLETION DATA:

(1) diameter (inches) 2"

(2) total depth (feet) 105'

(3) static water level (feet) 60 below above top of ground.

(4) casing Gal. 100'
 (material) (depth)
2" if telescope see back.
 (size)

(5) screen 5' 100'
 (length) (depth to top)
1 1/2 S.S. Ovals
 (size) (material)

(6) pump 3/4 6
 (HP) (yield gpm)
 (type power)

(7) electric log no
 (yes or no)
 (organization running log)

(8) how well bottom plugged Point

DRILLERS REMARKS:

RECEIVED


CODED

FEB 12 1969

MISSISSIPPI BOARD OF WATER COMMISSIONERS

If well telescopes please sketch and show depths.

GROUND LEVEL

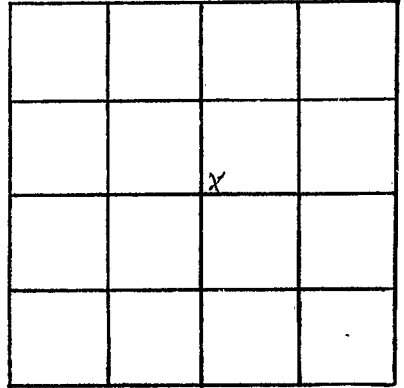

SECTION 36

Please indicate well location X.

ADDITIONAL INFORMATION

If more than one screen, show locations of each on sketch.