

**MISSISSIPPI
BOARD OF WATER COMMISSIONERS**
416 North State Street
Jackson, Mississippi 39201

WATER WELL DRILLERS LOG

Simpson
E 23
7-69

July 30 1969 W. H. Butler's Simpson
date well completed firm name county well located

LANDOWNER:
Mitchell Currie
Magee, Miss
(mailing address)

description of formations encountered	from	to
<u>Sand & Clay</u>	<u>0</u>	<u>20</u>
<u>Sand</u>	<u>20</u>	<u>40</u>
<u>Rock & Sand</u>	<u>40</u>	<u>60</u>
<u>Clay</u>	<u>60</u>	<u>80</u>

WELL LOCATION:
sec 36 T 20 N R 5 E
S W
5 miles N of Magee
(distance) (direction) (nearest town)

WELL PURPOSE: Home
(home, irrigation, municipal, industrial)

- WELL COMPLETION DATA:
- (1) diameter (inches) 2"
 - (2) total depth (feet) 80'
 - (3) static water level (feet) 40' ^{below} top of ground.
 - (4) casing PVC- 53
(material) (depth)
2" If telescope see back.
(size)
 - (5) screen 5' 53
(length) (depth to top)
2" SS
(size) (material)
 - (6) pump 1/2 6
(HP) (yield gpm)
Electric
(type power)
 - (7) electric log No
(yes or no)
 - (organization running log)
 - (8) how well bottom plugged 2" B.W.V.

(CODED)


NOV 2 1969

MISS. BD. OF
WATER COMMISSIONERS

DRILLERS REMARKS:

If well telescopes please sketch and show depths.

GROUND LEVEL

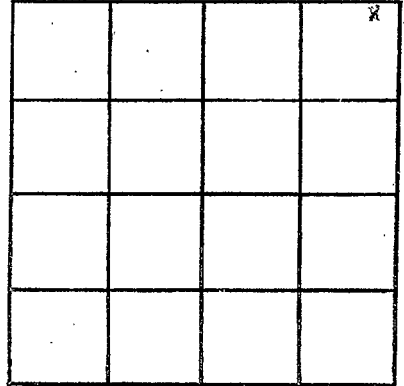

SECTION 36

Please indicate well location X.

ADDITIONAL INFORMATION

If more than one screen, show locations of each on sketch.