

SIMPSON

E33

2-25-71

MISSISSIPPI
 BOARD OF WATER COMMISSIONERS
 416 North State Street
 Jackson, Mississippi 39201

ELOG #136

WATER WELL DRILLERS LOG

CODED

Feb. 25
date well completed

171 R. E. Thompson
firm name

county well located

LANDOWNER:	description of formations encountered	from	to
B. J. Lupton <i>LAKE?</i>	Surface	0	10
Mendenhall (mailing address)	Sandy	10	30
WELL LOCATION:	Blue clay	30	76
sec. 22 T 2 N R 5 E	Sand	76	88
2 miles N/W of Mendenhall	Blue Clay	88	190
(distance) (direction) (nearest town)	Sand	190	254
WELL PURPOSE: home			
(home, irrigation, municipal, industrial)			

- WELL COMPLETION DATA:
- (1) diameter (inches) 2"
 - (2) total depth (feet) 254
 - (3) static water level (feet) 93 below top of ground.
 - (4) casing Plastic 230'
(material) (depth)
2"
(size) if telescope see back.
 - (5) screen 10', 230'
(length) (depth to top)
2", Plastic
(size) (material)
 - (6) pump 1 (HP) 6 (yield gpm)
Gen.
(type power)
 - (7) electric log yes
(yes or no)
M. N. S.
(organization running log)
 - (8) how well bottom plugged N/W well

CODED


DRILLERS REMARKS: well was
made in sand @ 76/88
in 1963 Water Survey Road

MAY 12 1971

MISS. BD. OF WATER COM.

If well telescopes please sketch and show depths.

GROUND LEVEL

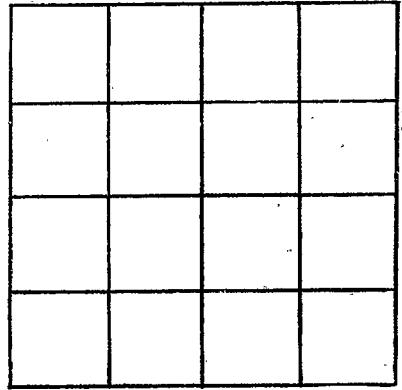

SECTION _____

Please indicate well location X.

ADDITIONAL INFORMATION

If more than one screen, show locations of each on sketch.