

SIMPSON  
E 34.  
4-12-71

MISSISSIPPI  
BOARD OF WATER COMMISSIONERS  
416 North State Street  
Jackson, Mississippi 39201  
WATER WELL DRILLERS LOG

**CODED**

4-11 1971 McWILLIAMS, WWS, SIMPSON  
date well completed firm name county well located

LANDOWNER: ARON.  
BURKET RT 1.  
MENDEHALL MISS.  
(mailing address)

description of formations encountered	from	to
<u>CLAY</u>	<u>0</u>	<u>11</u>
<u>SAND</u>	<u>11</u>	<u>21</u>
<u>GRAVEL</u>	<u>21</u>	<u>40</u>

WELL LOCATION:  
sec. 14 T. 2 S. R. E of W 5 1/2  
12 miles N of MENDEHALL  
(distance) (direction) (nearest town)

<u>22 PEE. GRAVEL</u>	<u>40</u>	<u>42</u>
<u>CLAY</u>	<u>42</u>	<u>84</u>
<u>WATER SAND</u>	<u>84</u>	<u>107</u>

WELL PURPOSE:  
(home, irrigation, municipal, industrial)

WELL COMPLETION DATA:

- (1) diameter (inches) 2"
- (2) total depth (feet) 107
- (3) static water level (feet) 84 below above top of ground.
- (4) casing 2" 1 102  
(material) (depth)  
(size) If telescope see back.
- (5) screen 5 FT 60# R. STALES SELF  
(length) (depth to top)  
(size) (material)
- (6) pump 1 320  
(HP) (yield gpm)  
ELECT  
(type power)
- (7) electric log NO  
(yes or no)

**CODED**

(organization running log)

APR 27 1971


(8) how well bottom plugged CLOSED

MISS. DE. OF  
WATER COM.

DRILLERS REMARKS:

If well telescopes please  
sketch and show depths.

GROUND LEVEL

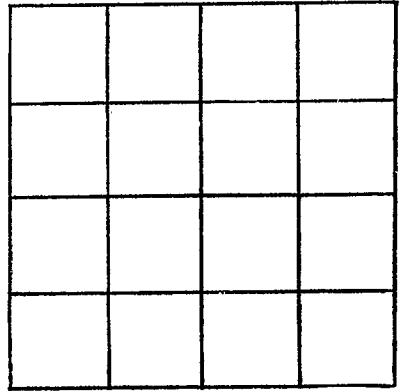

SECTION \_\_\_\_\_

Please indicate well location X.

ADDITIONAL INFORMATION

If more than one screen,  
show locations of each on sketch.