

SIMPSON
E35
11-1-71

MISSISSIPPI
 BOARD OF WATER COMMISSIONERS
 416 North State Street
 Jackson, Mississippi 39201

NOV 6 1971
CODED
 MISSISSIPPI
 WATER CONTROL

WATER WELL DRILLERS LOG

Nov. 1 1971 date well completed
 W. J. Butler firm name
 SIMPSON county well located

LANDOWNER: Robert Walker

Mendenhall, Miss
Rt -
 (mailing address)

WELL LOCATION:
 sec. 34 T. 2 N. R. 5 E.
 S W
5 miles N of Mendenhall
 (distance) (direction) (nearest town)

WELL PURPOSE:
 (home) irrigation, municipal, industrial

WELL COMPLETION DATA:

(1) diameter (inches) 2"

(2) total depth (feet) 90'

(3) static water level (feet) 80 below
 top of ground.

(4) casing galv., 84'
 (material) (depth)
2" if telescope see back.
 (size)

(5) screen 5, 84'
 (length) (depth to top)
2", 5' Steel
 (size) (material)

(6) pump 3/4 HP, 4 gal-
 (type power) (yield/gpm)
Electric

(7) electric log No
 (yes or no)

(organization running log)

(8) how well bottom plugged 2" BWV-


description of formations encountered	from	to
Sand + Clay	0	20
Rock + Clay	20	30
Clay + Sand	30	40
Gravel + Sand	40	50
Sand	50	60
Clay + Sand	60	70
Clay	70	77
Sand	77	90

CODED

DRILLERS REMARKS:

If well telescopes please sketch and show depths.

GROUND LEVEL

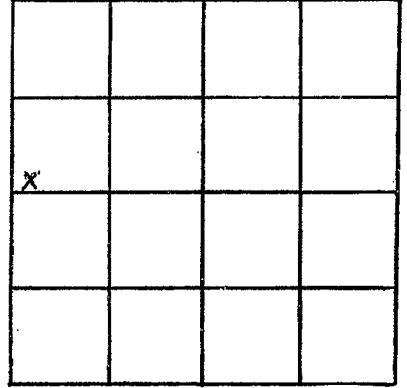

SECTION 34

Please indicate well location X.

ADDITIONAL INFORMATION

If more than one screen,
show locations of each on sketch.