

FLOG #163..

SIMPSON

E 36

9-15-72

MISSISSIPPI BOARD OF WATER COMMISSIONERS 416 North State Street Jackson, Mississippi 39201

CODED

WATER WELL DRILLERS LOG

9/15/72

date well completed

R.E. Thompson

firm name

Simpson

county well located

LANDOWNER:

description of formations encountered

from

to

Jack Davis

Martinville Miss

(mailing address)

WELL LOCATION:

sec 35 T 2 N R 5 E

1/2 miles S/W of Martinville (distance) (direction) (nearest town)

WELL PURPOSE: Farming (home, irrigation, municipal, industrial)

WELL COMPLETION DATA:

(1) diameter (inches) 2'

(2) total depth (feet) 177'

(3) static water level (feet) 100 below top of ground

(4) casing 2" (material) 97' (depth)

808 If telescope see back. (size)

(5) screen 10' (length) 97' (depth to top)

808 (size) Plastic (material)

(6) pump 2 (HP) 12 (yield gpm)

Gas (type power)

(7) electric log yes (yes or no)

M.N.S. (organization running log)

(8) how well bottom plugged

CODED


AUG 30 1972

MISS. BD. OF WATER COMMISSIONERS

DRILLERS REMARKS:

If well telescopes please sketch and show depths.

GROUND LEVEL

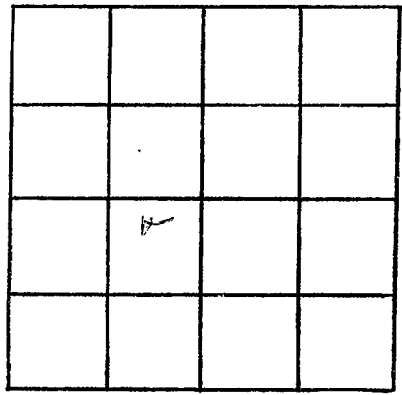

SECTION 35

Please indicate well location X.

ADDITIONAL INFORMATION

A series of horizontal lines for writing additional information.

If more than one screen, show locations of each on sketch.