

SIMPSON
E 37
1/11/78

MISSISSIPPI
BOARD OF WATER COMMISSIONERS
416 North State Street
Jackson, Mississippi 39201

CODED

WATER WELL DRILLERS LOG

Griner Drilling Services

SIMPSON Co.

1/11/78
date well completed

firm name

county well located

LANDOWNER: AMAX Petroleum

#1 AMAX Unit 28-9

(mailing address)

WELL LOCATION:

sec. 28 T 2 N R 5 E
3 miles NE of Monticello
(distance) (direction) (nearest town)

WELL PURPOSE:

(home, irrigation, municipal, industrial)

WELL COMPLETION DATA:

- (1) diameter (inches) 3"
- (2) total depth (feet) 420'
- (3) static water level (feet) NA below top of ground.
- (4) casing Steel 370' (material) (depth)
3" (size) if telescope see back.
- (5) screen 42' 380' (length) (depth to top)
3" Perforated Pipe (size) (material)
- (6) pump 60 (HP) (yield gpm)
AC (type power)
- (7) electric log NO (yes or no)

(organization running log)

- (8) how well bottom plugged orange
Peel

DRILLERS REMARKS:

Jimmy Hudson

description of formations encountered

from

to


Sand	0	105
Chalk Rock	106	126
Sand Gravel	127	168
Sand Chalk	169	189
Chalk	190	209
Strat. Lvs. Rocks	210	336
Sand	337	378

RECEIVED
JAN 17 1978

MISS. BD. OF WATER COMMISSIONERS

If well telescopes please sketch and show depths.

GROUND LEVEL

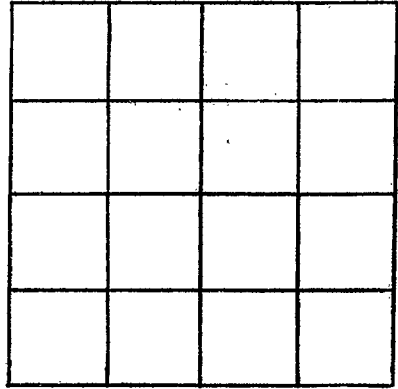

SECTION _____

Please indicate well location X.

ADDITIONAL INFORMATION

If more than one screen, show locations of each on sketch.