

SIMPSON
E 41
6-2-81

MISSISSIPPI DEPARTMENT OF NATURAL RESOURCES

Bureau of Land and Water Resources

Southport Mall

P.O. Box 10631

Jackson, Mississippi 39209

CODED

WATER WELL DRILLERS LOG

Griner Drilling Service, Inc Simpson

6-2-81 date well completed

Griner Drilling Service, Inc firm name

Simpson county well located

LANDOWNER:

Amax Petroleum

*The Amax Petroleum Bldg
1300 West Belt*

Houston (mailing address)

WELL LOCATION:

1820' S 12630' W

Sec. 28 T. 2 N. R. 5 E of

287 SW Martonville Field

(distance) (direction) (nearest town)

WELL PURPOSE: *oil field supply*
(home, irrigation, municipal, industrial)

WELL COMPLETION DATA:

(1) diameter (inches) *4"*

(2) total depth (feet) *525'*

(3) static water level (feet) *200'* (below/above top of ground)

(4) casing *Steel, 483'*
(material) (depth)
4"
(size) if telescope see back.

(5) screen *42', 441'*
(length) (depth to top)

4" (size) *perforated* (material)

(6) pump *70*
(HP) (yield gpm)

AC
(type power)

(7) electric log (yes or no)

(organization running log)

(8) how well bottom plugged *raise*

peel

DRILLERS REMARKS:


description of formations encountered

from

to


<i>gravel</i>	<i>0</i>	<i>63</i>
<i>chalk, streaked</i>	<i>63</i>	<i>336</i>
<i>sand</i>		
<i>streaked</i>	<i>336</i>	<i>420</i>
<i>sand</i>	<i>420</i>	<i>483</i>
<i>chalk</i>	<i>483</i>	<i>525</i>

CODED

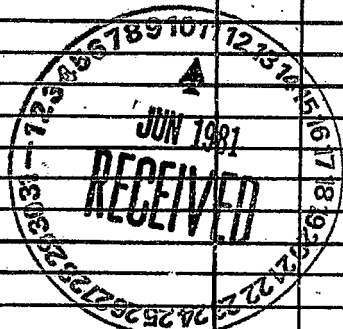

If well telescopes please
sketch and show depths.

GROUND LEVEL

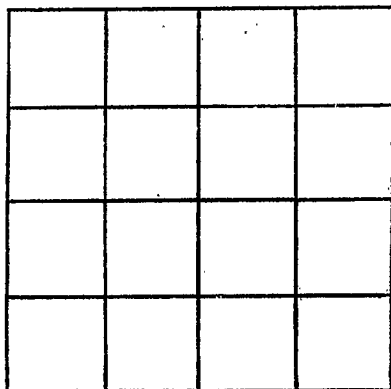

SECTION _____

Please indicate well location X.

ADDITIONAL INFORMATION

If more than one screen,
show locations of each on sketch.