

MISSISSIPPI DEPARTMENT OF NATURAL RESOURCES

Bureau of Land and Water Resources

Southport Mall

P.O. Box 10631

Jackson, Mississippi 39209

WATER WELL DRILLERS LOG

CODED

Simpson
E 43

3-31-86

Tom Griffith Well Service

Simpson, Ms

date well completed

firm name

county well located

LANDOWNER: Grace Francis Doby

300 Marshall St.

Shreveport, La 71101

(mailing address)

WELL LOCATION:

sec. 28 T 2 N R 5 E
S W
7 miles NW of Myrae, Ms
(distance) (direction) (nearest town)

WELL PURPOSE: Oil Location
(home, irrigation, municipal, industrial)

WELL COMPLETION DATA:

- (1) diameter (inches) 4"
- (2) total depth (feet) 490'
- (3) static water level (feet) 200 ^{below} above top of ground.
- (4) casing PVC 450'
(material) (depth)
N/A If telescope see back.
(size)
- (5) screen 40' 450'
(length) (depth to top)
4" PVC
(size) (material)
- (6) pump Air 65
(HP) (yield gpm)
Diesel
(type power)
- (7) electric log No
(yes or no)
N/A
(organization running log)
- (8) how well bottom plugged BWV

description of formations encountered

from

to

SANDY fill	0'	10'
SAND + GRAVEL	10	50'
HARD Chalk	50	135'
SAND	135	155'
HARD Rock	155	156'
CLAY	156	360'
fine Sand	360	390
CHALK	390	410
Streaked Sand	410	435
Good Sand	435	490

GAS TRANSPORTATION CORP. #1

UNIT 28-8 2100'S E 1200' W

OF NEICOR

CODED


RECEIVED
JUL 14 1986

Department of Natural Resources
Bureau of Land & Water Resources

DRILLERS REMARKS:

If well telescopes please sketch and show depths.

GROUND LEVEL

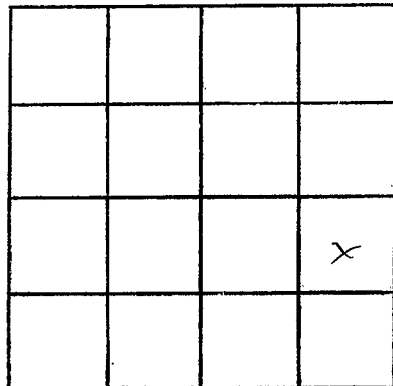

SECTION 28

Please indicate well location X.

ADDITIONAL INFORMATION

If more than one screen,
show locations of each on sketch.