

Simpson
E 46

MISSISSIPPI DEPARTMENT OF NATURAL RESOURCES
Bureau of Land and Water Resources
Southport Mall
P.O. Box 10631
Jackson, Mississippi 39209
WATER WELL DRILLERS LOG

CODED

2600 OR
2516

12/18 1989 date well completed
Morphis Bro. firm name
Simpson county well located

LANDOWNER: Justiss Oil
P.O. Box 1385
Jena, La 71342
(mailing address)

description of formations encountered	from	to
Wh. Sand	0	20
Sand & Pea Gravel	20	55
Gray & Brown Clay	55	80
Clay w/Sand Breaks	80	110
Sand	110	120
Clay w/Breaks	120	160
Fine Sand	160	175
Clay w/Breaks	175	200
Sand (Med White)	200	230
Blue Clay	230	267

WELL LOCATION:
sec 23 T 2 R 5
S W
9 miles N of Magee
(distance) (direction) (nearest town)

WELL PURPOSE: Rig Supply
(home, irrigation, municipal, industrial)

- WELL COMPLETION DATA:
- diameter (inches) 4"
 - total depth (feet) 267'
 - static water level (feet) 162 below above top of ground.
 - casing PVC, 237'
(material) (depth)
4" If telescope see back.
(size)
 - screen 30'
(length) (depth to top)
4", .014 PVC
(size) (material)
 - pump 7.5 80
(HP) (yield gpm)
Elec.
(type power)
 - electric log NO
(yes or no)

(organization running log)
 - how well bottom plugged BWV


970'S + 2150 W
OJ NE Cor
U
OF
470' N + 560' E OJ
SW Cor SW NE
DIRECTIONAL
LOG
JAN 17 1990

Department of Natural Resources
Bureau of Land & Water Resources

DRILLERS REMARKS: Screens
from 217' - 247'

If well telescopes please sketch and show depths.

GROUND LEVEL

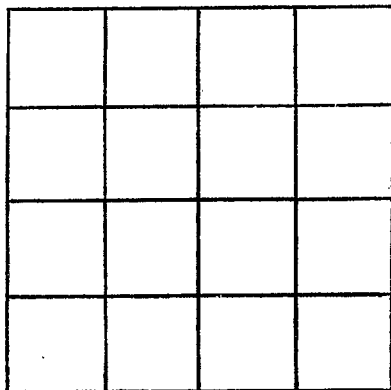

SECTION 23

Please indicate well location X.

ADDITIONAL INFORMATION

If more than one screen, show locations of each on sketch.