

MISSISSIPPI DEPARTMENT OF ENVIRONMENTAL QUALITY

Office of Land and Water Resources

P. O. Box 10631
Jackson, MS 39289-0631
WATER WELL DRILLERS LOG

COUNTY WELL LOCATED <i>Sheridan</i>		
WELL NUMBER <i>4 E 56</i>	CODED	PERMIT NUMBER <i>0-402</i>
NAME OF DRILLING FIRM <i>Tom Griffith</i>		NAME OF WELL <i>Water Well</i>
DATE WELL COMPLETED <i>4/23/96</i>		

NAME & MAILING ADDRESS OF LANDOWNER <i>COHO Resources</i>		
<i>14785 Preston Rd Suite 800</i>		
<i>DALLAS, TX 75280</i>		
WELL LOCATION: SEC	TOWNSHIP	RANGE
<i>23</i>	<i>2</i> <input checked="" type="radio"/> N <input type="radio"/> S	<i>5</i> <input type="radio"/> E <input checked="" type="radio"/> W
DISTANCE	DIRECTION	NEAREST TOWN
<i>1 1/2</i> Miles	<i>N</i>	of <i>Marshallville</i>
OTHER LANDMARK		
WELL PURPOSE: Home, Irrigation, Municipal, Industrial, Fish Pond, etc. <i>Rig Supply</i>		

PUMP DATA		
PUMP TYPE (Circle One): <input checked="" type="radio"/> Submersible, <input type="radio"/> Turbine, <input type="radio"/> Jet <input type="radio"/> Flowing Well, Other (Describe) _____		
POWER TYPE (Circle One): <input checked="" type="radio"/> Electric, <input type="radio"/> Tractor, <input type="radio"/> Diesel, <input type="radio"/> Gasoline, <input type="radio"/> Butane, Other (Describe) _____ H/P <i>5</i>		
Pump Capacity (GPM) <i>85</i>	No. of Stages	Setting Depth FT.
PUMP TEST		
Well yielded <i>85</i> GPM with a drawdown of _____ ft. after _____ hours of pumping		

Well Depth <i>165</i>	Casing Diameter (In.) <i>4</i>	Casing Length (Ft.) <i>125</i>
Type of Casing <i>PVC</i>	Hole Depth <i>165</i>	Depth to Static Water Level <i>85</i>

TYPE OF LOG RUN (Circle One):		No Log Run, Electric, Gamma Ray, Density, Sonic, Neutron, Other (Describe) _____
Name of Organization Running Log		

TYPE OF COMPLETION: (Circle One or More):
 Gravel Packed, Underreamed, Telescoped, Natural Development, Open Hole, Other (Describe) _____

GEOLOGIC DATA (Office Use Only)			
Surface Elev.	Geologic Unit	Unit Thickness	Depth to Top
Subs. SWL	Date	Analysis	Aquifer Test

WELL GROUTED TO A DEPTH OF *100* FEET
 Type Grout (circle one): Cement, Bentonite, or Mix

Driller's Remarks <i>1459' S E 1632' E</i> <i>OF [RECEIVED]</i>


SCREEN DATA		
Diameter - Inches <i>4</i>	Length - Feet <i>40</i>	Slot Size - Inches <i>25</i>
Screen Type <i>PVC</i>	Depth to Bottom - Feet <i>0</i>	

DESCRIPTION OF FORMATIONS ENCOUNTERED	FROM	TO	FORMATIONS (Continued) <i>1995</i>	FROM	TO
<i>Sandy Clay</i>	<i>1</i>	<i>40</i>			
<i>Limestone</i>	<i>40</i>	<i>80</i>			
<i>Clay</i>	<i>80</i>	<i>100</i>			
<i>SAND</i>	<i>100</i>	<i>165</i>			

IF MORE SPACE IS NEEDED, USE BACK

If well telescopes please
sketch and show depths.

GROUND LEVEL

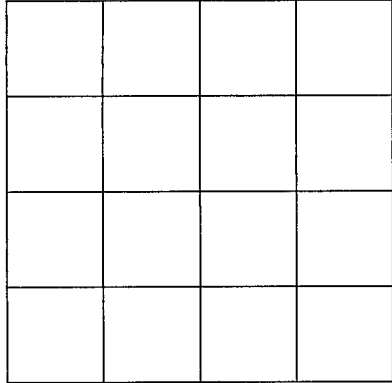

SECTION _____

Please indicate well location X.

ADDITIONAL INFORMATION

If more than one screen,
show location of each on sketch.