

MISSISSIPPI DEPARTMENT OF ENVIRONMENTAL QUALITY

Office of Land and Water Resources

P. O. Box 10631
Jackson, MS 39289-0631
WATER WELL DRILLERS LOG

COUNTY WELL LOCATED Simpson	
WELL NUMBER 2 E 57V	CODED
DATE WELL COMPLETED 3/23/96	

PERMIT NUMBER 0-402
NAME OF DRILLING FIRM Tom Griffith Well Co.
Well

NAME & MAILING ADDRESS OF LANDOWNER BOHO Resources		
14785 Preston Rd Suite 860		
DALLAS, TX 75280		
WELL LOCATION: SEC	TOWNSHIP	RANGE
22	2	5
DISTANCE DIRECTION NEAREST TOWN 1 1/2 Miles N of Marionville		
OTHER LANDMARK		
WELL PURPOSE: Home, Irrigation, Municipal, Industrial, Fish Pond, etc. Rig Supply		

PUMP DATA		
PUMP TYPE (Circle One): <input checked="" type="checkbox"/> Submersible Turbine, Jet, Flowing Well, Other (Describe)		
POWER TYPE (Circle One): <input checked="" type="checkbox"/> Electric, Tractor, Diesel, Gasoline, Butane, Other (Describe) H/P 5		
Pump Capacity (GPM) 85	No. of Stages	Setting Depth 180 FT.
PUMP TEST		
Well yielded 75 GPM with a drawdown of _____ ft. after _____ hours of pumping		

WELL DATA		
Well Depth 240	Casing Diameter (in.) 4	Casing Length (Ft.) 200
Type of Casing PVC	Hole Depth 240	Depth to Static Water Level 75
TYPE OF COMPLETION: (Circle One or More): <input checked="" type="checkbox"/> Gravel Packed, Underreamed, Telescoped, Natural Development, Open Hole, Other (Describe)		
WELL GROUTED TO A DEPTH OF 10 FEET Type Grout (circle one): <input checked="" type="checkbox"/> Cement, Bentonite, or Mix		

LOG DATA	
TYPE OF LOG RUN (Circle One): No Log Run, Electric, Gamma Ray, Density, Sonic, Neutron, Other (Describe)	
Name of Organization Running Log	

SCREEN DATA		
Diameter - Inches 4	Length - Feet 40	Slot Size - Inches 18
Screen Type Slot PVC		Depth to Bottom - Feet 0


GEOLOGIC DATA (Office Use Only)			
Surface Elev.	Geologic Unit	Unit Thickness	Depth to Top
Subs. SWL	Date	Analysis	Aquifer Test
Driller's Remarks 1246' S E 1971' wd = NB / cor			

DESCRIPTION OF FORMATIONS ENCOUNTERED	FROM	TO
Clay	1	120
Sand	120	135
Clay	135	200
Sand	200	240

FORMATIONS (Continued)		FROM	TO
MAY 14 1996			
Dept. of Environmental Quality Office of Land & Water Resources			
IF MORE SPACE IS NEEDED, USE BACK			

If well telescopes please sketch and show depths.

GROUND LEVEL

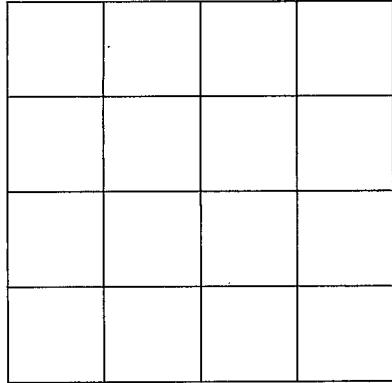

SECTION _____

Please indicate well location X.

ADDITIONAL INFORMATION

If more than one screen,
show location of each on sketch.