

**MISSISSIPPI DEPARTMENT OF ENVIRONMENTAL QUALITY**

Office of Land and Water Resources

P. O. Box 10631  
Jackson, MS 39289-0631  
**WATER WELL DRILLERS LOG**

COUNTY WELL LOCATED <b>Simpson</b>		CODED <b>COD 8 D</b>	
WELL NUMBER <b>-1 E 58</b>	PERMIT NUMBER <b>0-402</b>	NAME OF DRILLING FIRM <b>TOM GRISFILL WATER Well</b>	
DATE WELL COMPLETED <b>2-15-86</b>		NO. OF FEET <b>23-13</b>	

NAME & MAILING ADDRESS OF LANDOWNER  
**COHO Resources**  
**14785 Preston Rd suite 860**  
**DALLAS, TX 75280**

WELL LOCATION: SEC 23 TOWNSHIP 2 RANGE 5

DISTANCE 1 1/2 Miles DIRECTION N of NEAREST TOWN MARTINDALE

OTHER LANDMARK

WELL PURPOSE: Home, Irrigation, Municipal, Industrial, Fish Pond, etc.  
**RIG Supply**

**PUMP DATA**

PUMP TYPE (Circle One):  
Submersible, Turbine, Jet, Flowing Well, Other (Describe)

POWER TYPE (Circle One):  
Electric, Tractor, Diesel, Gasoline, Butane, Other (Describe) H/P 5

Pump Capacity (GPM) 85 No. of Stages 189 Setting Depth 189 FT.

PUMP TEST  
Well yielded 80 GPM with a drawdown of \_\_\_\_\_ ft. after \_\_\_\_\_ hours of pumping

**WELL DATA**

Well Depth <b>210</b>	Casing Diameter (In.) <b>4</b>	Casing Length (Ft.) <b>120</b>
Type of Casing <b>PVC</b>	Hole Depth <b>210</b>	Depth to Static Water Level <b>115</b>

TYPE OF COMPLETION: (Circle One or More):  
Gravel Packed, Underreamed, Telescoped, Natural Development, Open Hole, Other (Describe)

WELL GROUTED TO A DEPTH OF 10 FEET  
Type Grout (circle one): Cement Bentonite, or Mix

**LOG DATA**

TYPE OF LOG RUN (Circle One):  
Electric, Gamma Ray, Density, Sonic, No Log Run, Neutron, Other (Describe)

Name of Organization Running Log

**SCREEN DATA**

Diameter - Inches <b>4</b>	Length - Feet <b>40</b>	Slot Size - Inches <b>.015</b>
Screen Type <b>PVC slot</b>	Depth to Bottom - Feet <b>0</b>	

**GEOLOGIC DATA (Office Use Only)**

Surface Elev.	Geologic Unit	Unit Thickness	Depth to Top
Subs. SWL	Date	Analysis	Aquifer Test

Driller's Remarks  
**330' N E 9 53' E of**  
**SP/RECEIVED**


DESCRIPTION OF FORMATIONS ENCOUNTERED	FROM	TO	FORMATIONS (continued) 1995	FROM	TO
<b>Red Clay</b>	<b>1</b>	<b>50</b>			
<b>Clay</b>	<b>50</b>	<b>160</b>			
<b>Sand</b>	<b>160</b>	<b>210</b>			

Dept. of Environmental Quality  
Office of Land & Water Resources

IF MORE SPACE IS NEEDED, USE BACK

If well telescopes please sketch and show depths.

GROUND LEVEL

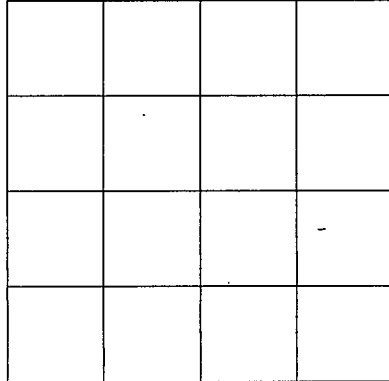

SECTION \_\_\_\_\_

Please indicate well location X.

ADDITIONAL INFORMATION

If more than one screen,  
show location of each on sketch.