

# State Well Report

Part 1

Mississippi Department of Environmental Quality  
Office of Land and Water Resources  
P.O. Box 10631  
Jackson, MS 39289-0631  
(601)961-5210  
(601)354-6938 (fax)

County: Simpson  
Permit #: \_\_\_\_\_  
Driller: Water Well Service  
Date drilling completed: 9-16-06

For Office Use Only:  
Aquifer: \_\_\_\_\_  
Well #: E-73  
L. S. Elevation: \_\_\_\_\_  
E-log #: \_\_\_\_\_

State Law requires that this report be prepared by the driller in detail and filed with the Department within 30 days of completion of drilling of the well.

Well Owner Information	Well Location
Owner Name: <u>Paul Robinson</u>	Latitude: <u>31.58.10</u> Longitude: <u>89.46.55</u>
Mailing Address: <u>1267 Poplar Springs Rd</u>	Method of Lat/Long (circle one): Conventional Survey,
<u>Mendenhall, MS</u>	USGS quad, Hand-held GPS, Survey-grade GPS
City State Zip Code	<u>1/4</u> <u>1/4</u> Sec <u>34</u> Twp <u>2N</u> Rng <u>5E</u>
Telephone No. ( <u>601</u> ) <u>847-5845</u>	Distance Direction Nearest Town
	Miles _____ of _____

Well Data

Purpose of Well (circle one) Home Industrial Public Supply Irrigation Fish Culture Other: Chicken houses

Date well drilling started: 9-12-06 Date well drilling completed: 9-16-06

If flowing, method of flow regulation: Valve \_\_\_\_\_ Other (describe) \_\_\_\_\_

Static Water Level: 82 feet above or below (circle one) land surface Date measured: 9-26-06

Method of Measurement (circle one) steel tape electric tape air line other: \_\_\_\_\_

Hole depth: 230 Well depth: \_\_\_\_\_ Well grouted to a depth of 25 feet

Type of grout (circle one): Cement Bentonite Mix

Casing length: 180 feet Casing diameter: 4 inches Type of casing: PVC

Screen length: 30 feet Screen diameter: 4 inches Type of screen: PVC

Screen slot size: 0.08 inches Setting depth: From 180 feet to 210 feet

Type of completion (circle all applicable): Gravel packed Underreamed Telescoped Open hole Natural Development

Other (describe): \_\_\_\_\_

Top of lap pipe or reduction in casing: \_\_\_\_\_ feet. If telescoped or more than one screen, describe on back of page

Logs run (circle all applicable): No log run Electric Gamma Ray Density Sonic Neutron Other: \_\_\_\_\_

Name of organization running log(s): State

I certify that the well was drilled, constructed, and completed in accordance with all applicable requirements of the Mississippi Department of Environmental Quality and/or the Mississippi Department of Health regulations and state laws.


Arnold Fincher Sr 0598 Arnold Fincher Sr  
Print Name of Water Well Contractor and License No. Signature of Water Well Contractor

RECEIVED  
OCT 18 2006  
BY: OLWR

If well telescopes please sketch below and show depths.

E-73

Ground Level:

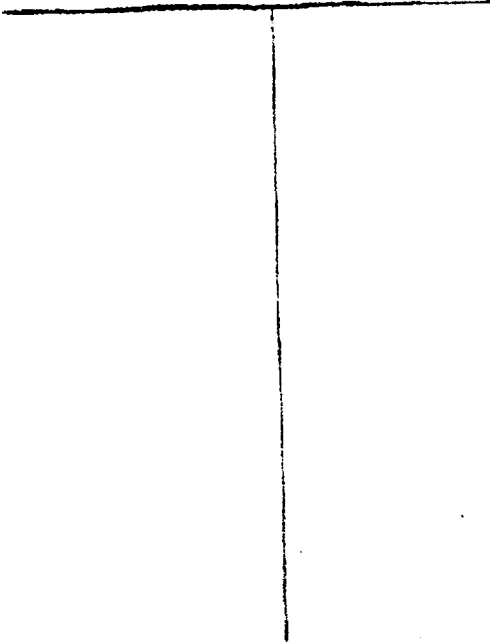

Description of Formations Encountered	From	To
Surface	0	25
clay	25	80
Sand	80	110
clay	110	170
Sand	170	215
clay	215	230

If more than one screen, show location of each on sketch

Sketch the property layout and include the following: 1) the well location; 2) any permanent structures on the property that may aid in locating the well; 3) any roads, power lines, or other items that may aid in locating the property and the well; 4) indicate direction.

Popular Springs Ry

Well

Landowner Name: Paul Robinson

Arvid Junch SV  
 Signature of Water Well Contractor

RECEIVED  
 OCT 18 2006  
 BY: OLWR

# STATE WELL REPORT

## Part 2

**Pump Installer's Completion Report**  
Mississippi Department of Environmental Quality  
Office of Land and Water Resources  
P.O. Box 10631  
Jackson, MS 39289-0631  
(601)961-5210  
(601)354-6938 (fax)

For Office Use Only:

Aquifer: \_\_\_\_\_

Well #: E-73

Elevation: \_\_\_\_\_

County: Simpson  
Permit #: \_\_\_\_\_  
Driller: Water Well Services  
Date completed: 9-28-06

This report should be prepared by the pump installer in detail and filed with the Department within 30 days of the installation of pump.

Well Owner Information	Well Location
Owner Name: <u>Paul Robinson</u>	Latitude: <u>31-58-10</u> Longitude: <u>89-46-55</u>
Mailing Address: <u>1267 Poplar Springs rd</u>	Method of Lat/Long (circle one): Conventional Survey,
<u>Mendenhall, MS</u>	USGS quad, Hand-held GPS, Survey-grade GPS
City State Zip Code	_____ 1/4 _____ 1/4 Sec <u>34</u> Twn <u>2N</u> Rng <u>5E</u>
Telephone No. <u>662 847-5845</u>	Distance Direction Nearest Town
	_____ Miles _____ of _____

Pump Type Circle one	Power Type Circle one
Air Lift Jet <u>Submersible</u>	Diesel Engine Gasoline Engine Natural Gas
Bucket Piston Turbine	<u>Electric Motor</u> Hand Tractor PTO
Centrifugal Rotary Flowing Well	Windmill Other (specify): _____
Other (specify): _____	Horse Power Rating of Motor: <u>5</u>
Date Pump Installed: <u>9-26-06</u>	Setting Depth: <u>180</u> feet
Rated Pump Capacity: <u>55</u> Gallons Per Minute	Number of Stages: <u>14</u>

Pump Test Data	Method of Measuring Water Level Circle one
Date Well Tested: <u>9-26-06</u>	Air Line <u>Electric Measuring Line</u> Steel Tape
Static Water Level (A): <u>82</u> Feet Below Land Surface	Other (specify): _____
Pumping Water Level (B): <u>100</u> Feet Below Land Surface	For flowing well, measured shut in head: _____ feet
Drawdown [(B) - (A)]: <u>18</u> Feet Below Land Surface	Well yielded _____ GPM with a drawdown of _____ feet after _____ hours of pumping
Test Pumping Rate: <u>60</u> Gallons Per Minute	
Duration of Pump Test (minimum 4 hours): <u>4</u> hours	

I HEREBY CERTIFY that the above statements are true to the best of my knowledge.

Arnold Fincher Sr 0598  
Print Name of Pump Installer and License No. (if applicable)

Arnold Fincher Sr  
Signature of Pump Installer

RECEIVED

OCT 18 2006

BY: OLWF