

Simpson  
E 2000  
10-15-76

MISSISSIPPI  
 BOARD OF WATER COMMISSIONERS  
 416 North State Street  
 Jackson, Mississippi 39201

WATER WELL DRILLERS LOG

Oct. 15 1976 W. G. Butler Simpson  
 date well completed firm name county well located


LANDOWNER:	description of formations encountered	from	to
<u>Royce Mize</u>			
<u>Mendenhall, Miss</u> <u>Rt 1</u> (mailing address)	<u>Clay</u>	<u>1</u>	<u>5</u>
	<u>Red Sand</u>	<u>5</u>	<u>40</u>
	<u>Gravel</u>	<u>40</u>	<u>60</u>
	<u>Sand</u>	<u>60</u>	<u>85</u>
<b>WELL LOCATION:</b>			
sec <u>28</u> T <u>2</u> N R <u>5</u> E S W			
<u>6</u> miles <u>N</u> of <u>Magee</u>			
(distance) (direction) (nearest town)			
<b>WELL PURPOSE:</b> <u>Farm</u> (home, irrigation, municipal, industrial)			
<b>WELL COMPLETION DATA:</b>			
(1) diameter (inches) <u>2"</u>			
(2) total depth (feet) <u>85</u>			
(3) static water level (feet) <u>50</u> <u>below</u> above top of ground.			
(4) casing <u>galv.</u> (material) (depth)			
<u>2"</u> (size) if telescope see back.			
(5) screen <u>5'</u> (length) (depth to top)			
<u>2"</u> (size) <u>S.S.</u> (material)			
(6) pump <u>1</u> (HP) <u>10</u> (yield gpm)			
<u>Electric</u> (type power)			
(7) electric log <u>No</u> (yes or no)			
(organization running log)			
(8) how well bottom plugged <u>2" B.W.V.</u>			
<b>DRILLERS REMARKS:</b>			
<u>Last trip to Check well</u>			
<u>11-9-76</u>			

**RECEIVED**  
 NOV 19 1976

MISS. BD. OF WATER COMMISSIONERS

If well telescopes please sketch and show depths.

GROUND LEVEL

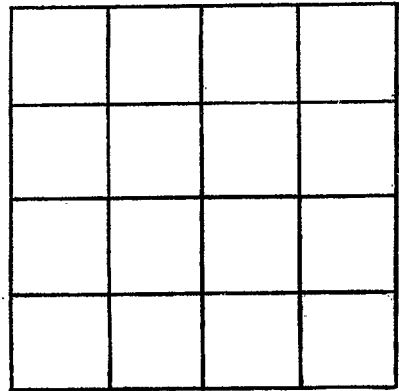

SECTION \_\_\_\_\_

Please indicate well location X.

ADDITIONAL INFORMATION

If more than one screen,  
show locations of each on sketch.