

Simpson
E 2001
7-26-79

MISSISSIPPI
 BOARD OF WATER COMMISSIONERS
 416 North State Street
 Jackson, Mississippi 39201

WATER WELL DRILLERS LOG

July 26 1979 TOM GRIFFITH
 date well completed well name
PLUMBING & WELL SERVICE, INC. Simpson
 county/well located

LANDOWNER:
Mr. Allen Floyd
Mendenhall, Miss.
 (mailing address)

description of formations encountered	from	to
<u>Top soil</u>	<u>0</u>	<u>1</u>
<u>Clay</u>	<u>1</u>	<u>8</u>
<u>Shale</u>	<u>8</u>	<u>23</u>
<u>Gravel</u>	<u>23</u>	<u>41</u>
<u>Sand</u>	<u>41</u>	<u>62</u>
<u>Chalk</u>	<u>62</u>	<u>121</u>
<u>Sand</u>	<u>121</u>	<u>196</u>

WELL LOCATION:
 sec. 26 T 20 N R. 5 E
7 miles E of Mendenhall
 (distance) (direction) (nearest town)

WELL PURPOSE: Home
 (home, irrigation, municipal, industrial)

WELL COMPLETION DATA:

(1) diameter (inches) 4"

(2) total depth (feet) 196 ft.

(3) static water level (feet) 158 ft. below top of ground.

(4) casing plastic 196 ft.
 (material) (depth)
4" if telescope see back.
 (size)

(5) screen 20 ft. 176 ft.
 (length) (depth to top)
4" plastic
 (size) (material)

(6) pump 1/2 HP 12 gals.
 (HP) (yield gpm)
Electric
 (type power)

(7) electric log no
 (yes or no)


(organization running log)

(8) how well bottom plugged
Back Wash Valve

DRILLERS REMARKS:
rec'd 9/21/79
duu - L.W.

If well telescopes please sketch and show depths.

GROUND LEVEL

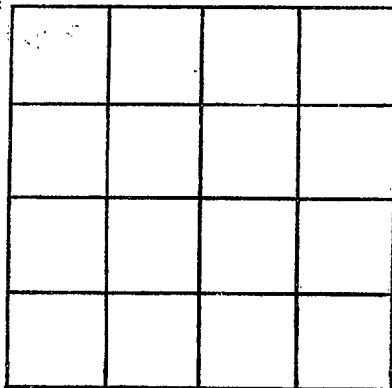

SECTION _____

Please indicate well location X.

ADDITIONAL INFORMATION

If more than one screen;
show locations of each on sketch.