

MISSISSIPPI DEPARTMENT OF ENVIRONMENTAL QUALITY
Bureau of Land and Water Resources

P. O. Box 10631
Jackson, MS 39289-0631
WATER WELL DRILLERS LOG

COUNTY WELL LOCATED	
SIMPSON	
WELL NUMBER	CODED
E	
2003	
DATE WELL COMPLETED	
6-8-92	

PERMIT NUMBER
NAME OF DRILLING FIRM
DIXIE WELL SERVICE
MENDENHALL, MISSISSIPPI

NAME & MAILING ADDRESS OF LANDOWNER		
MARK BLAIR		
MENDENHALL, MISSISSIPPI		
WELL LOCATION:	SEC	TOWNSHIP
	29	2
		N
		5
		W
DISTANCE	DIRECTION	NEAREST TOWN
6	SE	MENDENHALL
OTHER LANDMARK		
CHICKEN HOUSE		
WELL PURPOSE: Home, Irrigation, Municipal, Industrial, Fish Pond, etc.		
CHICKEN HOUSE		


PUMP DATA		
PUMP TYPE (Circle One):		
<input checked="" type="radio"/> Submersible	Turbine	Jet
Flowing Well, Other (Describe)		
POWER TYPE (Circle One):		
<input checked="" type="radio"/> Electric	Tractor	Diesel
Gasoline		Butane
Other (Describe)		H/P 1/2
Pump Capacity (GPM)	No. of Stages	Setting Depth
10	8	109'
PUMP TEST		
10	8	109'
Well yielded 10 GPM with		
a drawdown of 25 ft.		
after 24r hours of pumping		

WELL DATA		
Well Depth	Casing Diameter (In.)	Casing Length (Ft.)
110'	4"	90'
Type of Casing	Hole Depth	Depth to Static Water Level
PVC	150'	80'
TYPE OF COMPLETION: (Circle One or More):		
<input checked="" type="radio"/> Gravel Packed	<input type="radio"/> Underreamed	<input type="radio"/> Telescoped
<input type="radio"/> Natural Development	<input type="radio"/> Open Hole	<input type="radio"/> Other
Top of Lap Pipe or Reduction in Casing		
FEET	IF TELESCOPED OR MORE THAN ONE SCREEN: USE BACK PAGE	

LOG DATA	
TYPE OF LOG RUN (Circle One):	
<input checked="" type="radio"/> Electric	No Log Run, Gamma Ray, Density, Sonic, Neutron, Other (Describe)
Name of Organization Running Log	
MISSISSIPPI GEOLOGY	

SCREEN DATA		
Diameter - Inches	Length - Feet	Slot Size - Inches
4"	20'	.008
Screen Type	Depth to Bottom - Feet	
PVC SLOTTED	110'	


GEOLOGIC DATA (Office Use Only)			
Surface Elev.	Geologic Unit	Unit Thickness	Depth to Top
Subs. SWL	Date	Analysis	Aquifer Test
Driller's Remarks			
HIGH ELLIVATION CAUSE			
WELL TO HAVE LOW YEILD			

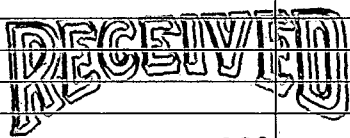DESCRIPTION OF FORMATIONS ENCOUNTERED	FROM	TO	FORMATIONS (Continued)	FROM	TO
TOP SOIL	0	6	 JUN 29 1992 Dept. of Environmental Quality Bureau of Land & Water Resources		
WHITE AND PINK CLAY	6	73			
CORSE WHITE SAND	73	110			
GREY CLAY	110	150			
GREY CLAY	150	=			

IF MORE SPACE IS NEEDED, USE BACK

If well telescopes please
sketch and show depths.

GROUND LEVEL

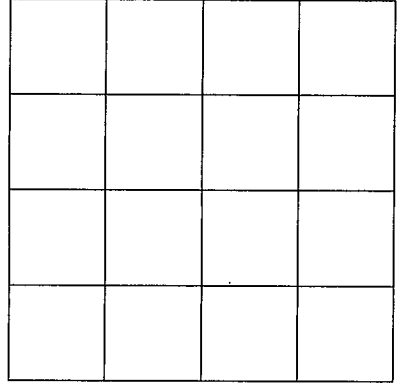

SECTION _____

Please indicate well location X.

ADDITIONAL INFORMATION

Lined area for providing additional information.

If more than one screen,
show location of each on sketch.