

**MISSISSIPPI DEPARTMENT OF ENVIRONMENTAL QUALITY**  
Bureau of Land and Water Resources

P. O. Box 10631  
Jackson, MS 39289-0631  
**WATER WELL DRILLERS LOG**

COUNTY WELL LOCATED <b>SIMPSON</b>	
WELL NUMBER <b>E</b>	CODED
<b>2000</b>	
DATE WELL COMPLETED <b>8-13-94</b>	

PERMIT NUMBER
NAME OF DRILLING FIRM <b>PARKER WELL SERVICE</b>

NAME & MAILING ADDRESS OF LANDOWNER <b>SAMMY HAYMAN</b>			
<b>RT. 1</b>			
<b>Mendenhall</b>			
WELL LOCATION: SEC	TOWNSHIP	RANGE	
<b>13</b>	<b>2</b>	<b>(N) S</b>	<b>5 (E) W</b>
DISTANCE	DIRECTION	NEAREST TOWN	
<b>7</b> Miles	<b>South</b>	<b>PUCKETT</b>	
OTHER LANDMARK <b>MARTINVILLE</b>			
WELL PURPOSE: Home, Irrigation, Municipal, Industrial, Fish Pond, etc. <b>CHICKEN HOUSES</b>			

PUMP DATA			
PUMP TYPE (Circle One): <input checked="" type="radio"/> Submersible, Turbine, Jet, Flowing Well, Other (Describe)			
POWER TYPE (Circle One): <input checked="" type="radio"/> Electric, Tractor, Diesel, Gasoline, Butane, Other (Describe) H/P <b>15</b>			
Pump Capacity (GPM)	No. of Stages	Setting Depth	
<b>20</b>	<b>14</b>	<b>140</b>	FT.
PUMP TEST			
Well yielded <b>30</b> GPM with a drawdown of <b>10</b> ft. after <b>2 1/2</b> hours of pumping			


WELL DATA		
Well Depth <b>150</b>	Casing Diameter (In.) <b>4"</b>	Casing Length (Ft.) <b>130'</b>
Type of Casing <b>PVC</b>	Hole Depth <b>150</b>	Depth to Static Water Level <b>90'</b>
TYPE OF COMPLETION: (Circle One or More): <input checked="" type="checkbox"/> Gravel Packed, <input type="checkbox"/> Underreamed, <input type="checkbox"/> Telescoped, <input checked="" type="checkbox"/> Natural Development, <input type="checkbox"/> Open Hole, <input type="checkbox"/> Other		
Top of Lap Pipe or Reduction in Casing <b>FEET</b> IF TELESCOPED OR MORE THAN ONE SCREEN: USE BACK PAGE		

LOG DATA	
TYPE OF LOG RUN (Circle One): <input type="radio"/> No Log Run, <input type="radio"/> Electric, <input type="radio"/> Gamma Ray, <input type="radio"/> Density, <input type="radio"/> Sonic, <input type="radio"/> Neutron, Other (Describe)	
Name of Organization Running Log	

SCREEN DATA		
Diameter - Inches <b>4"</b>	Length - Feet <b>20'</b>	Slot Size - Inches <b>008</b>
Screen Type <b>PVC</b>	Depth to Bottom - Feet <b>150'</b>	

GEOLOGIC DATA (Office Use Only)			
Surface Elev.	Geologic Unit	Unit Thickness	Depth to Top
Subs. SWL	Date	Analysis	Aquifer Test


Driller's Remarks <b>CORSE SAND @ 120-150 MADE GOOD WELL</b>
---

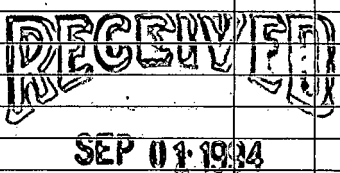DESCRIPTION OF FORMATIONS ENCOUNTERED	FROM	TO	FORMATIONS (Continued)	FROM	TO
<b>CLAY</b>	<b>0</b>	<b>20</b>			
<b>SAND</b>	<b>20</b>	<b>40</b>			
<b>CLAY</b>	<b>40</b>	<b>70</b>			
<b>Lime Rock</b>	<b>70</b>	<b>71</b>			
<b>CLAY</b>	<b>71</b>	<b>120</b>			
<b>CORSE SAND</b>	<b>120</b>	<b>150</b>			

If well telescopes please sketch and show depths.

GROUND LEVEL

R-5-E

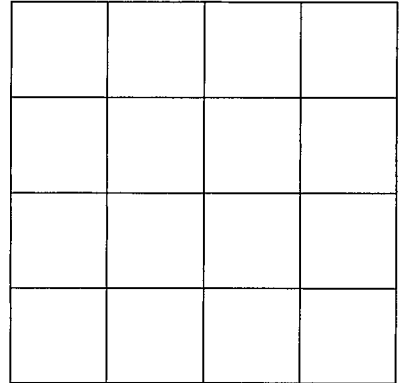

SECTION 13

Please indicate well location X.

ADDITIONAL INFORMATION

GO TO PUCKETT  
~~TAKE ROAD~~ GO EAST  
TO 541 GO SOUTH  
6 miles TO HAYMAN  
LAKE ROAD TAKE  
LEFT 2nd. HOUSE  
ON RIGHT WELL  
BEHIND HOUSE

If more than one screen,  
show location of each on sketch.