

**MISSISSIPPI  
BOARD OF WATER COMMISSIONERS**  
416 North State Street  
Jackson, Mississippi 39201

CODED

**WATER WELL DRILLERS LOG**

date well completed 19 Feb 17 1967 firm name W.H. Delladonna, Inc. Simpson county well located Simpson


LANDOWNER: <u>Collins</u>	description of formations encountered	from	to
(mailing address)		0	77
<b>WELL LOCATION:</b> sec <u>20</u> T <u>36N</u> R <u>6E</u> <u>3 1/2</u> miles <u>E</u> of <u>Monticello</u> (distance) (direction) (nearest town)	<u>clay &amp; chalk</u> <u>chalk &amp; sand</u> <u>water sand</u>		<u>34</u> <u>22</u> <u>2.1</u>
<b>WELL PURPOSE:</b> (home, irrigation, municipal, industrial)			
<b>WELL COMPLETION DATA:</b> (1) diameter (inches) _____ (2) total depth (feet) _____ (3) static water level (feet) _____ below/above top of ground. (4) casing _____ (material), _____ (depth), _____ (size) if telescope see back. (5) screen <u>6 ft.</u> (length), _____ (depth to top) <u>1/4</u> (size) <u>6 gal. copper</u> (material) (6) pump <u>1/2</u> (HP), _____ (yield gpm) <u>Elect.</u> (type power) (7) electric log _____ (yes or no) _____ (organization running log) (8) how well bottom plugged _____			
<b>DRILLERS REMARKS:</b>			

CODED

MAY 20 1968  
 MISS. BD. OF WATER COMMISSIONERS

If well telescopes please sketch and show depths.

GROUND LEVEL

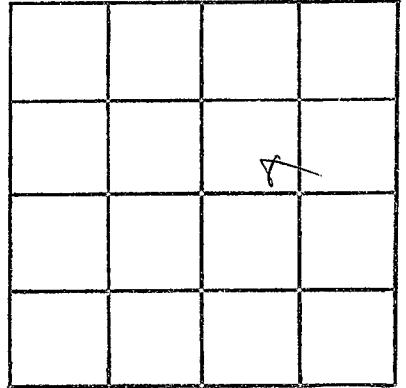

SECTION 20

Please indicate well location X.

ADDITIONAL INFORMATION

If more than one screen, show locations of each on sketch.