

MISSISSIPPI
BOARD OF WATER COMMISSIONERS
416 North State Street
Jackson, Mississippi 39201

CODED

CODED
ED

WATER WELL DRILLERS LOG

Simpson
78
10-18-68

Oct 18 1968 W.G. Butler SIMPSON
date well completed firm name county well located

LANDOWNER:
MONROE BURNHAM
MONROEHALL MISS
Rt. 1- (mailing address)
WELL LOCATION:
sec. 6 T 2 N R. 6 E
S W
2 1/2 miles S.W. of Whitaker
(distance) (direction) (nearest town)

description of formations encountered	from	to
Red sand clay	0	10
clay	10	20
SANDY clay	20	30
sand	30	60
clay	60	70
Sand + clay	70	100
Sands	100	130

WELL PURPOSE: home
(home, irrigation, municipal, industrial)

WELL COMPLETION DATA:
(1) diameter (inches) 2"
(2) total depth (feet) 130'
(3) static water level (feet) 45' ^{below} _{above} top of ground.
(4) casing galv. 125
(material) (depth)
____ if telescope see back.
(size)
(5) screen 5' 125'
(length) (depth to top)
2" S.S.
(size) (material)
(6) pump 1/2 .6
(HP) (yield gpm)
Electric
(type power)
(7) electric log No
(yes or no)

(organization running log)
(8) how well bottom plugged 2" AWY.

CODED

CODED


MAR 13 1969

MISS. BD. OF
WATER COMMISSIONERS

DRILLERS REMARKS:

If well telescopes please sketch and show depths.

GROUND LEVEL

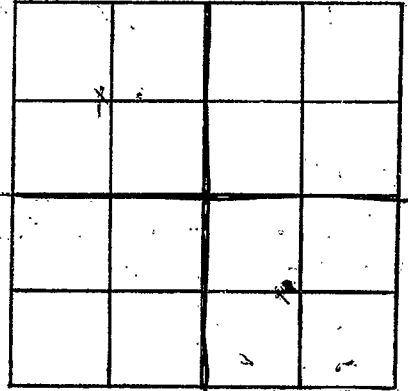

SECTION 6

Please indicate well location X.

ADDITIONAL INFORMATION

If more than one screen, show locations of each on sketch.