

SIMPSON
F9
12-31-70

MISSISSIPPI
BOARD OF WATER COMMISSIONERS
416 North State Street
Jackson, Mississippi 39201

FEB 17 1971
MISS. BD. OF
WATER COMM.

CODED

WATER WELL DRILLERS LOG

12-31-70 date well completed 1970 D.W.K. Barnes Water Wells firm name Simpson county well located

LANDOWNER: Jack Barnes
Route 16
Macond Hall Miss.
(mailing address)

WELL LOCATION:
sec. 19 T 2 N R 16 E
S W
miles of (distance) (direction) (nearest town)

WELL PURPOSE:
(home, irrigation, municipal, industrial)

- WELL COMPLETION DATA:
- (1) diameter (inches) 2
 - (2) total depth (feet) 160
 - (3) static water level (feet) 65 below above top of ground.
 - (4) casing Galv. (material), (depth) 2' If telescope see back. (size)
 - (5) screen 4' (length), (depth to top) 0.7 (size), Stainless Steel (material)
 - (6) pump 3/4 (HP), 6 (yield gpm)
Elec. (type power)
 - (7) electric log No. (yes or no)
- (organization running log)
- (8) how well bottom plugged


description of formations encountered	from	to
Red clay	0	8
yellow clay		
1 Sand mixed	8	34
yellow clay	34	69
Blue clay	69	84
Fine Sand	84	85
Blue clay	85	96
Fine Sand	96	98
Blue clay	98	130
Fine Sand	130	140
Porous Sand	140	160

CODED

DRILLERS REMARKS:

If well telescopes please sketch and show depths.

GROUND LEVEL

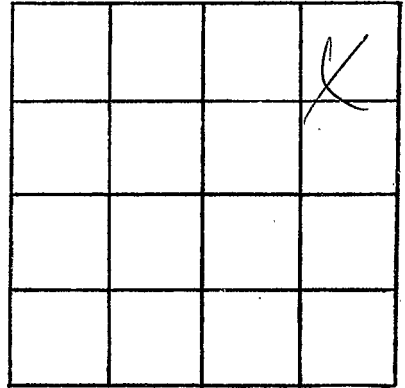

SECTION 19

Please indicate well location X.

ADDITIONAL INFORMATION

If more than one screen,
show locations of each on sketch.