

CODED

MISSISSIPPI
 BOARD OF WATER COMMISSIONERS
 416 North State Street
 Jackson, Mississippi 39201

MAR 21 1972

SIMPSON
F11
2-18-72

WATER WELL DRILLERS LOG

Feb. 18 1972 M. G. Butler Simpson
 date well completed firm name county well located

LANDOWNER:
Larry Johnson
Magee Miss. A3
 (mailing address)

WELL LOCATION:
 sec 23 T 20 N R 6E
8 miles N of Magee
 (distance) (direction) (nearest town)

WELL PURPOSE: Farm
 (home, irrigation, municipal, industrial)

WELL COMPLETION DATA:

(1) diameter (inches) 2"

(2) total depth (feet) 90'

(3) static water level (feet) _____ below above top of ground.

(4) casing galv. _____, _____ below above (material) (depth) 2" If telescope see back. (size)

(5) screen 5' _____, _____ (length) (depth to top) 2" Stainless Steel (size) (material)

(6) pump 1 _____ (HP) (yield gpm) Electric (type power)

(7) electric log No (yes or no)

(organization running log)

(8) how well bottom plugged 8" B.W.V.

DRILLERS REMARKS:


description of formations encountered	from	to
Red Clay + sand	1	10
Sand	10	20
Clay + sand	20	30
Sand	30	50
Clay	50	60
Clay + sand	60	65
Clay -	65	90

CODED

CODED

If well telescopes please sketch and show depths.

GROUND LEVEL

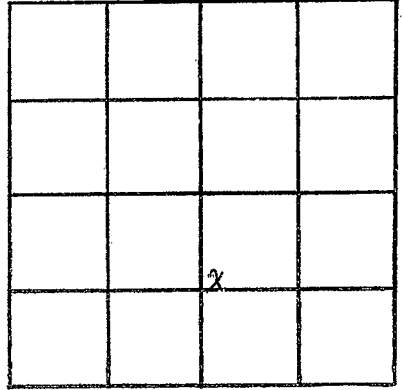

SECTION 23-

Please indicate well location X.

ADDITIONAL INFORMATION

If more than one screen,
show locations of each on sketch.