

SIMPSON
 F12
 3-16-77
 Log # 184

MISSISSIPPI
 BOARD OF WATER COMMISSIONERS
 416 North State Street
 Jackson, Mississippi 39201

CODED ✓

WATER WELL DRILLERS LOG

3-16-1977 date well completed
 CRIVER DRILLING SERVICES SIMPSON firm name
 county well located

LANDOWNER: AMAX PETROLEUM
 (mailing address)

description of formations encountered	from	to
SAND + Clay streaks	0	114
CLAY	114	186
SAND WITH Clay streaks	186	260
CLAY	260	330
ROCKS WITH thin SAND streaks	330	410
CLAY	410	800
SAND streaks + CLAY streaks	800	1005
CLAY + ROCKS (HARD at bot.)	1005	1158

WELL LOCATION: 2000 N + 2145 W of S
 sec. 22 T. 2 S R. 6 E
 (distance) miles (direction) of (nearest town)

WELL PURPOSE: oil well supply
 (home, irrigation, municipal, industrial)

- WELL COMPLETION DATA:
- (1) diameter (inches) 3"
 - (2) total depth (feet) 1001
 - (3) static water level (feet) 325 (below/above top of ground)
 - (4) casing B.I. 750
 (material) (depth)
3"
 (size) if telescope see back.
 - (5) screen 250 750
 (length) (depth to top)
3" slotted pipe 3" (008 size)
 (size) (material)
 - (6) pump Air Comp. 45
 (HP) (yield-gpm)
Elect.
 (type power)
 - (7) electric log Yes
 (yes or no)
MGS
 (organization running log)
 - (8) how well bottom plugged

CODED


MAR 18 1977

DRILLERS REMARKS:

MISS. BD. OF WATER COMMISSIONERS

If well telescopes please sketch and show depths.

GROUND LEVEL

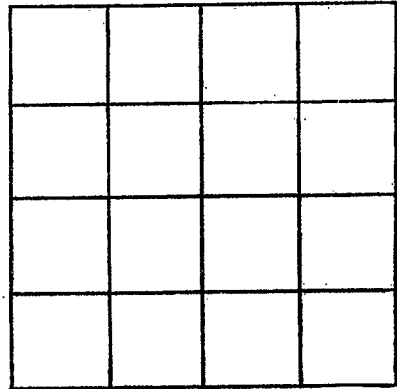

SECTION _____

Please indicate well location X.

ADDITIONAL INFORMATION

If more than one screen, show locations of each on sketch.