

MISSISSIPPI DEPARTMENT OF NATURAL RESOURCES

Bureau of Land and Water Resources

Southport Mall

P.O. Box 10631

Jackson, Mississippi 39209

CODE 7

WATER WELL DRILLERS LOG

Griner Drilling Service, Inc.

Simpson

~~SIMPSON~~
F13
8/21/84
8-21-84

date well completed

firm name

county well located

LANDOWNER:

description of formations encountered

from

to

Exeter Drilling

144 Elk Place

Suite 1502

New Orleans, La. 70112

WELL LOCATION: 800' N + 1400' W

Sec. 29 T. 2 N. R. 6 E S. 1 cor

2.9 miles Magee

WELL PURPOSE: oilfield supply

(home, irrigation, municipal, industrial)

WELL COMPLETION DATA:

- (1) diameter (inches) 3"
- (2) total depth (feet) 483'
- (3) static water level (feet) 150' below top of ground.
- (4) casing steel, 483' (material), (depth)
- 3" (size) if telescope see back.
- (5) screen 42', 441' (length), (depth to top)
- 3", perforated (size), (material)
- (6) pump —, 60 (HP), (yield gpm)
- AC (type power)
- (7) electric log — (yes or no)
- (organization running log)

(8) how well bottom plugged orange peel

DRILLERS REMARKS:

clay	0	45
sand	45	60
clay, sand, few rocks	60	370
clay, rocks	370	455
sand	455	483


CODED

DEPT. OF NATURAL RESOURCES
BUREAU OF LAND & WATER RESOURCES

SEP - 4 1984
RECEIVED

If well telescopes please sketch and show depths.

GROUND LEVEL

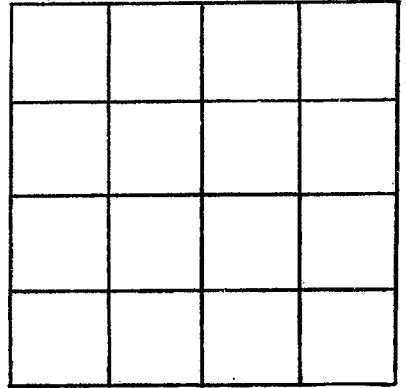

SECTION _____

Please indicate well location X.

ADDITIONAL INFORMATION

If more than one screen,
show locations of each on sketch.