

MISSISSIPPI DEPARTMENT OF NATURAL RESOURCES

Bureau of Land and Water Resources

Southport Mall

P.O. Box 10631

Jackson, Mississippi 39209

WATER WELL DRILLERS LOG

Griner Drilling Service, Inc.

CODED

SIMPSON

Simpson  
F 14

2717

6-3-90

date well completed

firm name

county well located

LANDOWNER:

Pacific Enterprises Oil Co.  
3040 Post Oak Blvd.  
Suite 600  
Houston, Texas 77056

description of formations encountered

from

to

clay, sand

0 21

clay, rock

21 120

sand

120 155

clay, rock

155 399

WELL LOCATION: 1130'S + 1725'W

sec. 30 T 20 N R 6 E of  
Ne. 1/4 of Martinville  
Shoreline (direction) of (nearest town)

WELL PURPOSE: oilfield supply  
(home, irrigation, municipal, industrial)

WELL COMPLETION DATA:

- (1) diameter (inches) 4"
- (2) total depth (feet) 399'
- (3) static water level (feet) 50' below top of ground.
- (4) casing PVC 125' (material) (depth)  
4" (size) if telescope see back.
- (5) screen 30' From 125' to 155' (length) (depth to top)  
4" PVC slotted (size) (material)
- (6) pump 7 1/2 HP 75 (yield gpm)  
230 Volt 3 phase (type power)
- (7) electric log (yes or no)

RECEIVED

JUN 18 1990

(organization running log)


- (8) how well bottom plugged 4" plug with backwash valve

DRILLER'S REMARKS:

Department of Natural Resources  
Bureau of Land & Water Resources

If well telescopes please  
sketch and show depths.

GROUND LEVEL

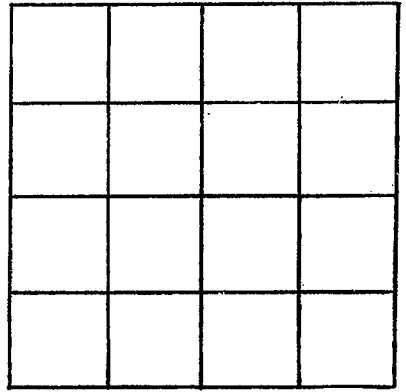

SECTION \_\_\_\_\_

Please indicate well location X.

ADDITIONAL INFORMATION

If more than one screen,  
show locations of each on sketch.