

MISSISSIPPI DEPARTMENT OF ENVIRONMENTAL QUALITY

Office of Land and Water Resources

P. O. Box 10631
Jackson, MS 39289-0631
WATER WELL DRILLERS LOG

COUNTY WELL LOCATED
Simpson

WELL NUMBER # 1 CODED _____

PERMIT NUMBER _____

NAME OF DRILLING FIRM
Roy V. West Drilling

DATE WELL COMPLETED
2-28-03

NAME & MAILING ADDRESS OF LANDOWNER
David Johnson
190 Blair Rd
Magee MS 39111

Latitude: _____
Longitude: _____

WELL LOCATION. SEC 35 TOWNSHIP 2 RANGE 6 (N/S/E/W)

DISTANCE 6 Miles DIRECTION NE of NEAREST TOWN Magee

OTHER LANDMARK _____

WELL PURPOSE: Home, Irrigation, Municipal, Industrial, Fish Pond, etc.
Poultry Farm

PUMP DATA

PUMP TYPE (Circle One):
Submersible Turbine, Jet, Flowing Well,
Other (Describe) _____

POWER TYPE (Circle One):
Electric, Tractor, Diesel, Gasoline, Butane,
Other (Describe) _____ H/P 5

DESCRIPTION OF FORMATIONS ENCOUNTERED	FROM	TO
<u>CLAY</u>	<u>0</u>	<u>3</u>
<u>SAND</u>	<u>3</u>	<u>21</u>
<u>CLAY w/ ROCK STRKS</u>	<u>21</u>	<u>202</u>
<u>SAND / COARSE IN BTM</u>	<u>202</u>	<u>242</u>

RECEIVED

MAY 19 2003

BY: OLWR

WELL DATA

Well Depth 242 Casing Diameter (In.) 4 Casing Length (Ft.) 202

Type of Casing PVC Hole Depth 242 Depth to Static Water Level 105

TYPE OF COMPLETION: (Circle One or More):
Gravel Packed, Underreamed, Telescoped,
Natural Development, Open Hole, Other
(Describe) _____ 10

WELL GROUTED TO A DEPTH OF 10 FEET
Type Grout (circle one): Cement, Bentonite, or Mix

SCREEN DATA

Diameter - Inches <u>4</u>	Length - Feet <u>20</u>	Slot Size - Inches <u>.010</u>
Screen Type <u>PVC slotted</u>		Depth to Bottom - Feet <u>242</u>

Top of Lap Pipe or Reduction in Casing _____ FEET

IF TELESCOPED OR MORE THAN ONE SCREEN: USE BACK PAGE


I certify that the well was drilled, constructed and completed in accordance with all applicable Requirements of the Mississippi Department of Environmental Quality and/or the Mississippi Department of Health regulations and state laws.

David West 0-1072
Signature of Licensed Driller and License No.

5-7-03
Date

If well telescopes please sketch and show depths.

GROUND LEVEL

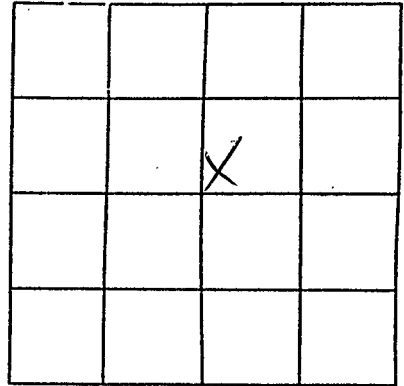

SECTION 35

Please indicate well location X.

Pump Capacity (GPM) <u>55</u>	No. of Stages	Setting Depth <u>140</u> FT.
----------------------------------	---------------	---------------------------------

PUMP TEST

Well yielded _____ GPM with
a drawdown of _____ ft.
after _____ hours of pumping

LOG DATA

TYPE OF LOG RUN (Circle One): No Log Run,
Electric, Gamma Ray, Density, Sonic, Neutron,
Other (Describe) _____

Name of Organization Running Log

GEOLOGIC DATA (Office Use Only)

Surface Elev.	Geologic Unit	Unit Thickness	Depth to Top
Subs. SWL	Date	Analysis	Aquifer Test

Driller's Remarks

If more than one screen,
show location of each on sketch.