

Simpson  
 F Joel  
 3-18-77

MISSISSIPPI  
 BOARD OF WATER COMMISSIONERS  
 416 North State Street  
 Jackson, Mississippi 39201

WATER WELL DRILLERS LOG

3-18-77 date well completed 19 Adcock water well Inc. firm name Simpson county well located

LANDOWNER: Danny Kayman  
21 Mendenhall, Miss.  
 (mailing address)

description of formations encountered	from	to
clay	0	10
clay + sand	10	20
clay + sand	20	30
clay + sand	30	40
clay + sand	50	60
clay + sand	60	70
sand	70	80
rock	80	90
clay	90	100
clay	100	110
clay + sand	110	120
clay + sand	120	130
sand	130	140
sand	140	150
clay	150	155

WELL LOCATION:  
 sec. 14 T. 2 N R. 5 E  
off. 12<sup>9</sup> miles N East of mezer  
 (distance) (direction) (nearest town)

WELL PURPOSE: Home Use  
 (home, irrigation, municipal, industrial)

- WELL COMPLETION DATA:
- (1) diameter (inches) 4
  - (2) total depth (feet) 150
  - (3) static water level (feet) 80 below above top of ground.
  - (4) casing PVC, 120  
 (material) (depth)  
 (size) if telescope see back.
  - (5) screen 3.0, 150  
 (length) (depth to top)  
4", PVC  
 (size) (material)
  - (6) pump 3, 10  
 (HP) (yield. gpm)  
Electric  
 (type power)
  - (7) electric log NO  
 (yes or no)  
 (organization running log)
  - (8) how well bottom plugged open


DRILLERS REMARKS: Sit on clay bottom

RECEIVED  
 APR 27 1977

Miss. Bd. of Water Comm.

If well telescopes please sketch and show depths.

GROUND LEVEL

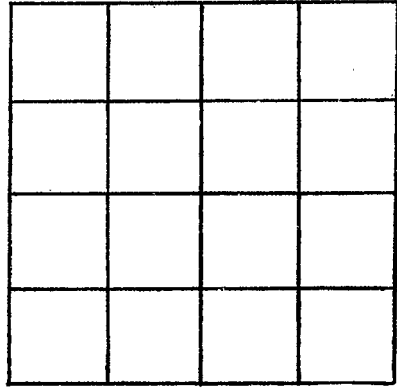

SECTION \_\_\_\_\_

Please indicate well location X.

ADDITIONAL INFORMATION

If more than one screen,  
show locations of each on sketch.