

MISSISSIPPI DEPARTMENT OF NATURAL RESOURCES

Bureau of Land and Water Resources

Southport Mall

P.O. Box 10631

Jackson, Mississippi 39209

WATER WELL DRILLERS LOG

Simpson
E 2002

oct 1 1983

83 Billy Elly Nilly Co.

Simpson
county well located

date well completed 1983 firm name county well located

LANDOWNER: Ronnie Teater
606 Jan Drive
Mendenhall, Miss.
(mailing address) 39114

description of formations encountered	from	to
CLAY	0	40
Sand	40	68'

WELL LOCATION:
sec. 9 T 2 N R 6 E
S W
8 miles N.E. of Mendenhall
(distance) (direction) (nearest town)

WELL PURPOSE: home
(home, irrigation, municipal, industrial)

- WELL COMPLETION DATA:
- (1) diameter (inches) 5 3/4"
 - (2) total depth (feet) 68"
 - (3) static water level (feet) 42 (below) above top of ground.
 - (4) casing P.V.C. 68'
(material) (depth)
(size) If telescope see back.
 - (5) screen 10' 58'
(length) (depth to top)
2" P.V.C.
(size) (material)
 - (6) pump (HP) (yield gpm)
(type power)
 - (7) electric log (yes or no)
(organization running log)
 - (8) how well bottom plugged

DRILLERS REMARKS:


DEPT. OF NATURAL RESOURCES
BUREAU OF LAND & WATER RESOURCES

NOV 1 1983

RECEIVED

If well telescopes please sketch and show depths.

GROUND LEVEL

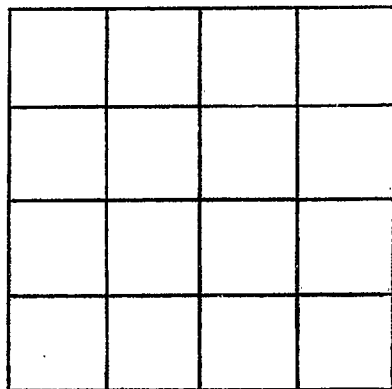

SECTION _____

Please indicate well location X.

ADDITIONAL INFORMATION

If more than one screen, show locations of each on sketch.