

MISSISSIPPI DEPARTMENT OF NATURAL RESOURCES

Bureau of Land and Water Resources

Southport Mall

P.O. Box 10631

Jackson, Mississippi 39209

WATER WELL DRILLERS LOG

Simpson
F 2003

6-26
date well completed


1986 Roy V. West
firm name

Simpson
county well located

LANDOWNER:	description of formations encountered	from	to
Bill Jeffries			
(mailing address)	CLAY	1	11
WELL LOCATION:	SAND	11	14
sec <u>2 T 2 N</u> R <u>6 E</u>	CLAY	14	57
<u>4</u> miles <u>SE</u> of <u>WHITE OAK</u>	SAND	57	63
(distance) (direction) (nearest town)	CLAY	63	211
	Limestone	211	217
WELL PURPOSE:	CLAY	217	285
(home, irrigation, municipal, industrial)	SAND	285	320
WELL COMPLETION DATA:			
(1) diameter (inches) <u>4"</u>			
(2) total depth (feet) <u>310'</u>			
(3) static water level (feet) <u>56'</u> below above top of ground.			
(4) casing <u>PVC</u> , <u>280'</u> , (material) (depth)			
(size) if telescope see back.			
(5) screen <u>30'</u> , <u>280'</u> (length) (depth to top)			
<u>4"</u> , <u>PVC</u> (size) (material)			
(6) pump <u>1/2</u> , <u>18</u> (HP) (yield gpm)			
<u>REA</u> (type power)			
(7) electric log <u>No</u> (yes or no)			
(organization running log)			
(8) how well bottom plugged <u>WASH VALVE</u>			
DRILLERS REMARKS:			

If well telescopes please sketch and show depths.

GROUND LEVEL

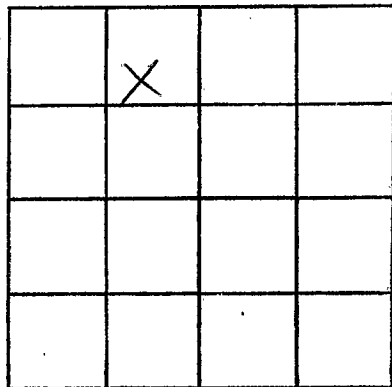

SECTION 2

Please indicate well location X.

ADDITIONAL INFORMATION

If more than one screen, show locations of each on sketch.