

SIMPSON
 G
 7-28-75
 E Log # 175

MISSISSIPPI
 BOARD OF WATER COMMISSIONERS
 416 North State Street
 Jackson, Mississippi 39201

CODED

WATER WELL DRILLERS LOG

7/28/75 19 K. E. Simpson Simpson
 date well completed firm name county well located

LANDOWNER:	description of formations encountered	from	to
(mailing address)			
<u>Don Tanner</u>	<u>top soil</u>	<u>0</u>	<u>2</u>
	<u>sandy clay</u>	<u>2</u>	<u>40</u>
	<u>blue clay</u>	<u>40</u>	<u>255</u>
	<u>sand</u>	<u>255</u>	<u>285</u>
WELL LOCATION: sec. <u>1</u> T. <u>1</u> N. <u>2</u> R. <u>2</u> E. <u>W</u> <u>1 1/2</u> miles <u>S</u> of <u>Winnfield, La.</u> (distance) (direction) (nearest town)			
WELL PURPOSE: <u>home</u> (home, irrigation, municipal, industrial)			
WELL COMPLETION DATA:			
(1) diameter (inches) <u>4 X 2</u>			
(2) total depth (feet) <u>355</u>			
(3) static water level (feet) <u>100</u> <u>below</u> above ground.			
(4) casing <u>plastic</u> , <u>255</u> (material) (depth)			
<u>4 X 2</u> If telescope see back. (size)			
(5) screen <u>10'</u> , <u>255</u> (length) (depth to top)			
<u>008</u> , <u>plastic</u> (size) (material)			
(6) pump <u>3/4</u> <u>12</u> (HP) (yield gpm)			
<u>Sub.</u> (type power)			
(7) electric log <u>yes</u> (yes or no)			
<u>Miss. W. A. C.</u> (organization running log)			
(8) how well bottom plugged <u>Sub.</u>			
DRILLERS REMARKS:			



CODED

AUG 21 1975

MISSISSIPPI WATER COMMISSION

If well telescopes please sketch and show depths.

GROUND LEVEL

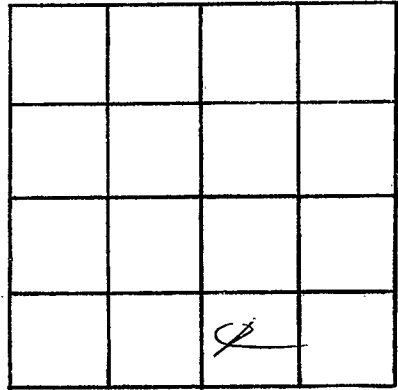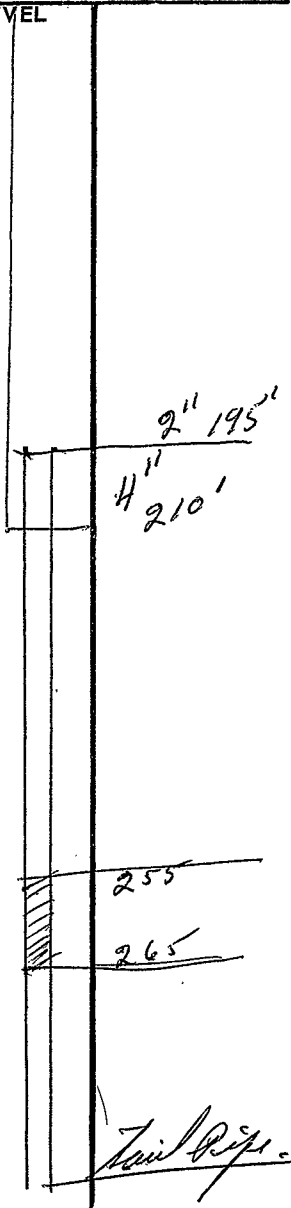

SECTION 1

Please indicate well location X.

ADDITIONAL INFORMATION

Multiple horizontal lines for additional information.

If more than one screen, show locations of each on sketch.