

SIMPSON

G1

8-10-66

MISSISSIPPI BOARD OF WATER COMMISSIONERS

WATER WELL DRILLERS LOG

Date: 9/10, 1966, Driller: T. B. Andrews

CODER County Simpson

(Name)

(1) Owner of Land: Ernest Pendlington

(Name)

Rt. 2 Georgetown, Miss

(Address)

(2) Location: SE 1/4, NW 1/4, Sec. 31, T4N, R7E

1 N

7 miles N.E. of Georgetown

(distance)

(direction)

(Nearest Town)

(3) Topography: Flat

(Hilly)

(Flat)

(Level)

(4) Purpose of Well: Domestic

(Domestic Irrigation

Municipal, Industrial, Other)

Information upon completion of well:

(1) Diameter 4 inches.

(2) Total Depth 125 feet.

(3) Water Level 98 feet below top of ground.

(4) Cased to 125', Size 4"

(5) Screen: Size 4", Length 5'

(6) Were any formations sealed against pollution?

yes, no.

If YES depth of formation

Why

Drillers Remarks:

Plastic well

Description & Color of Materials Sand, Clay, Red Clay, Shell, etc.

Thick-ness Feet

Depth Feet

gray clay

20' 20'

sand

3' 23'


Blue clay / Gray clay

75' 98'

Coarse sand

27' 125'

CODER

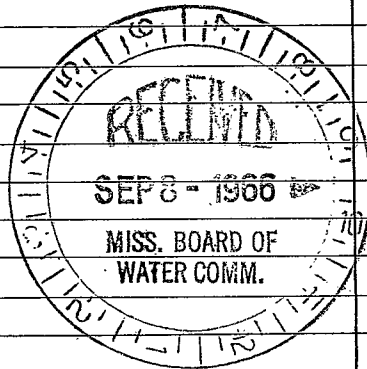

(Use Back Side)

31

Well No.

