

Simpson
 # G4
 8-29-60

WATER WELL DRILLERS LOG CODED

(?)

Date: 8-29, 1960, Driller: Quick + Duce County P.R.
 (Name)

(1) Owner of Land: John Henry Coleman
 (Name)
 Mendenhall Miss.
 (Address)

Description & Color of Materials Sand, Clay, Red Clay, Shell, etc.	Thick- ness Feet	Depth Feet
Surface Clay	0	10
Sand + gravel	10	111

(2) Location: 1/4, 1/4, Sec. 36 T. R.
 12 miles west, of Mendenhall
 (distance) (direction) (Nearest Town)

(3) Topography: (Hilly) (Flat) (Level)

(4) Purpose of Well: Domestic
 (Domestic Irrigation
 Municipal, Industrial, Other)


Information upon completion of well:

- (1) Diameter 2 inches.
- (2) Total Depth 111 feet.
- (3) Water Level 7.5 feet below top of ground.
- (4) Cased to _____, Size _____
- (5) Screen: Size 2", Length 5'
- (6) Were any formations sealed against pollution?
 _____ yes, No no.

If YES depth of formation _____

Why _____

Drillers Remarks: Sand all the way but, made a good well -

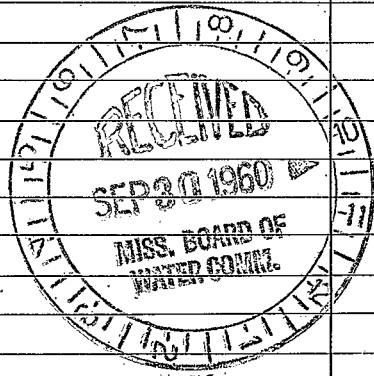

12

Well No.

(Use Back Side)

