

SIMPSON
G 8
6-24-71

MISSISSIPPI
BOARD OF WATER COMMISSIONERS
416 North State Street
Jackson, Mississippi 39201

E LOG # 140

WATER WELL DRILLERS LOG

CODED

6/24/71 date well completed 19 H. E. Thompson firm name Simpson county well located

LANDOWNER:
J. D. Kien
(mailing address)

description of formations encountered	from	to
<u>Sand and Gravel</u>	0	40
<u>Blue clay</u>	40	96
<u>Fine Sand and Gravel</u>	96	160
<u>Blue clay</u>	160	320
<u>Sand Gravel</u>	320	400
<u>Blue clay</u>	400	420
<u>Sand Gravel</u>	420	440
<u>Blue clay</u>	440	460

WELL LOCATION:
sec. 36 T 1 N R. 2 E
1 miles E of Zion
(distance) (direction) (nearest town)

WELL PURPOSE: Water
(home, irrigation, municipal, industrial)

- WELL COMPLETION DATA:
- (1) diameter (inches) 2"
 - (2) total depth (feet) 460'
 - (3) static water level (feet) 4 ^{below} above top of ground.
 - (4) casing Plastic, 386'
(material) (depth)
2"
(size) If telescope see back.
 - (5) screen 10', 386'
(length) (depth to top)
2", Plastic
(size) (material)
 - (6) pump 3 1/2 10
(HP) (yield gpm)
Jet
(type power)
 - (7) electric log yes
(yes or no)
Miss. W. S. # 8
(organization running log)
 - (8) how well bottom plugged By water

CODED


JUL 7 1971

DRILLERS REMARKS: Showing 4 1/2 ft. of
millian. 36 ft. D. m.
Jet Pump 1/2 hp 10 ft. D. m.
4' above ground 4 ft. D. m.

MISS. Bd. OF
WATER COMM.

If well telescopes please sketch and show depths.

GROUND LEVEL

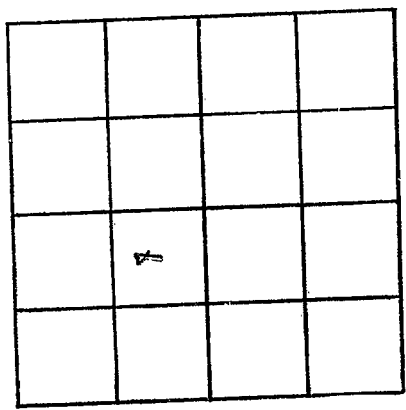

SECTION سی ۳

Please indicate well location X.

ADDITIONAL INFORMATION

Lined area for additional information.

If more than one screen, show locations of each on sketch.