

SIMPSON
G-9
7-29-71

MISSISSIPPI BOARD OF WATER COMMISSIONERS
416 North State Street
Jackson, Mississippi 39201
WATER WELL DRILLERS LOG

CODED

July 29 1971 R. E. Thompson Simpson
date well completed firm name county well located

LANDOWNER:	description of formations encountered	from	to
<u>Jack Stein</u>	<u>Sand</u>	<u>0</u>	<u>38</u>
(mailing address)	<u>Blue Clay</u>	<u>38</u>	<u>240</u>
WELL LOCATION:	<u>Thin Sand</u>	<u>240</u>	<u>264</u>
sec. <u>32</u> T. <u>1</u> N. R. <u>2 E</u>	<u>Blue Clay</u>	<u>264</u>	<u>408</u>
<u>8 1/4</u> miles <u>W</u> of <u>Dimit</u>	<u>Sand</u>	<u>408</u>	<u>430</u>
(distance) (direction) (nearest town)	<u>Blue Clay</u>	<u>430</u>	<u>445</u>
WELL PURPOSE: <u>Drain</u>			
(home, irrigation, municipal, industrial)			
WELL COMPLETION DATA:			
(1) diameter (inches) <u>2"</u>			
(2) total depth (feet) <u>445'</u>			
(3) static water level (feet) <u>4'</u> ^{below} above top of ground.			
(4) casing <u>Plastic 420'</u> (material) (depth)			
<u>2"</u> (size) If telescope see back.			
(5) screen <u>2" x 10' 420'</u> (length) (depth to top)			
<u>#.006, Plastic</u> (size) (material)			
(6) pump <u>1 HP 20</u> (HP) (yield gpm)			
<u>air</u> (type power)			
(7) electric log <u>yes</u> (yes or no)			
<u>M. S. S.</u> (organization running log)			
(8) how well bottom plugged <u>Not plugged</u>			
DRILLERS REMARKS:			


CODED

AUG 2 1971

MISS. BD. OF WATER COMMISSIONERS

If well telescopes please sketch and show depths.

GROUND LEVEL

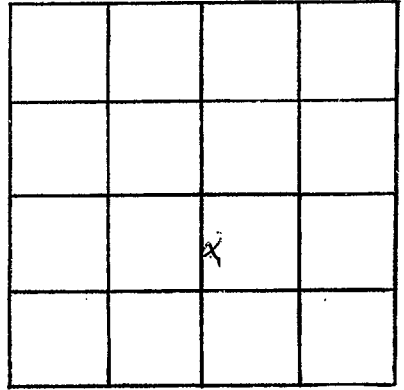

SECTION 32

Please indicate well location X.

ADDITIONAL INFORMATION

If more than one screen,
show locations of each on sketch.