

SIMPSON
G15
8-25-72

ELOG # 164

MISSISSIPPI
 BOARD OF WATER COMMISSIONERS
 416 North State Street
 Jackson, Mississippi 39201

WATER WELL DRILLERS LOG

COV.

8/25/72 19 R.E. Thompson Simpson
 date well completed firm name county well located

LANDOWNER:
P. J. McDonald
Crystal Springs
 (mailing address)

description of formations encountered	from	to
clay	0	10
blue clay	10	42
sand	42	50
blue clay	50	64
sand	64	90
blue clay	90	130
sand	130	195
blue clay	195	255
sand	255	296
clay sand	296	315

WELL LOCATION:
 sec. 10 T 1 N S R 1 E W
 (distance) miles (direction) of (nearest town)

WELL PURPOSE:
 (home irrigation, municipal, industrial)

- WELL COMPLETION DATA:
- (1) diameter (inches) 2"
 - (2) total depth (feet) 315'
 - (3) static water level (feet) 27 below above top of ground.
 - (4) casing plastic 280'
 (material) (depth)
2"
 (size) if telescope see back.
 - (5) screen 15' 280
 (length) (depth to top)
1008 plastic
 (size) (material)
 - (6) pump none 60
 (HP) (yield gpm)
none
 (type power)
 - (7) electric log yes
 (yes or no)
Mrs. S. S.
 (organization running log)
 - (8) how well bottom plugged worked

CODED


DOT 91 10/11

MISS. BD. OF
 WATER COMMISSIONERS

DRILLERS REMARKS:

If well telescopes please sketch and show depths.

GROUND LEVEL

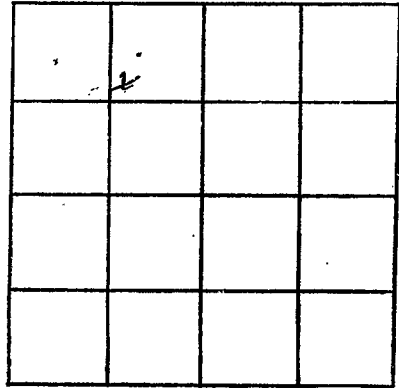

SECTION 10

Please indicate well location X.

ADDITIONAL INFORMATION

If more than one screen,
show locations of each on sketch.